FILED
RECEIVED
SEP 6 1967
COUNTY SURVEYOR
DOUGLAS COUNTY, ORE.

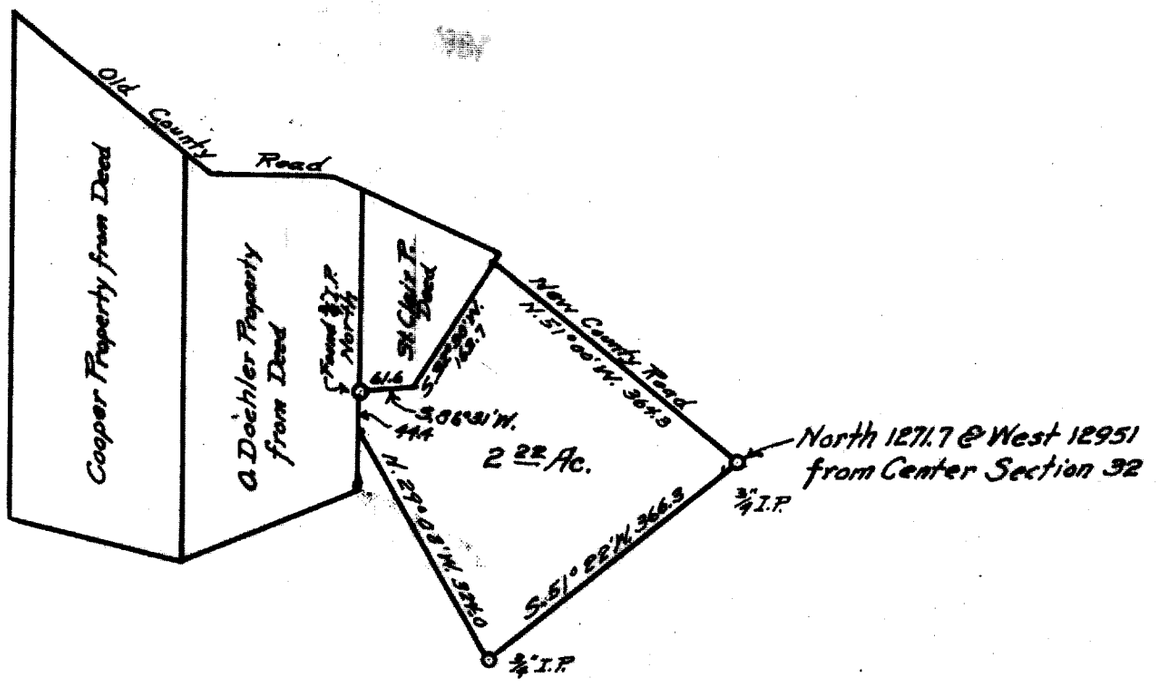

[redacted]

COUNTY SURVEYOR'S OFFICE
DOUGLAS COUNTY, OREGON.
SURVEY FOR
J.C.Smith in
Section 32, T.32S., R.6W.W.M.
Geo.J.Wenderoth, Deputy. Sept.1967.
Scale 1"=100ft.

REGISTERED
OREGON
LAND SURVEYOR

Geo. J. Wenderoth

MARCH 10, 1944
George J. Wenderoth
5

Found Witnes Corner Brass Cap to Section 32 Set by Co.Surveyor 1955

Pink C.S. [redacted] 54/50-2