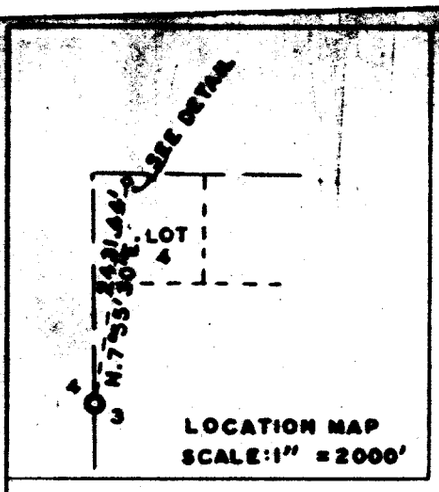

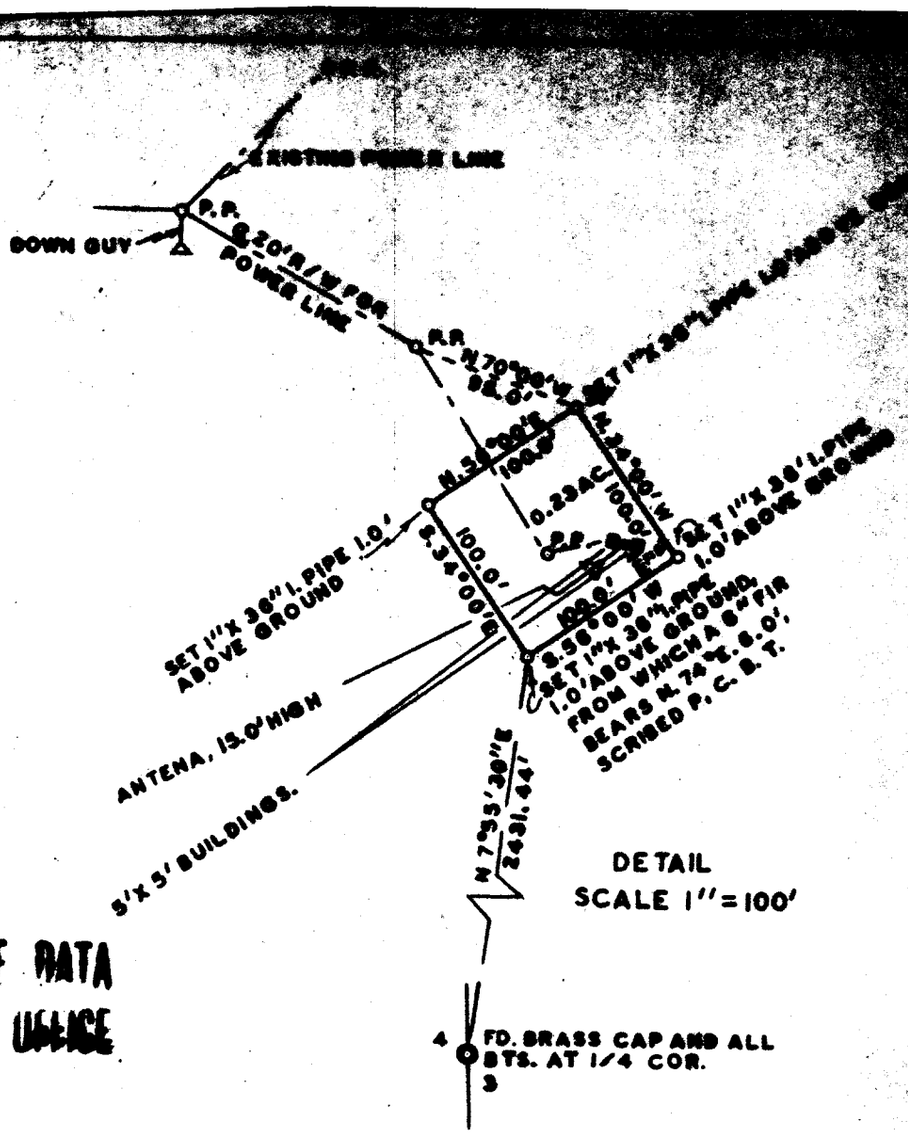

NOTE: BEARINGS ARE MAGNETIC WITH A VAR. OF 20°00'E.

COUNTY SURVEYORS FILE DATA

SURVEYOR'S STATEMENT

James W. Byron states he is by occupation a licensed surveyor employed by the Camas Valley Grange No. 521, to make the survey of the television relay station site as described and shown on this map; that the survey of said works was made by him commencing and ending on the 21 day of October, 1967; and that such survey is accurately represented upon this map.

James W. Byron

APPLICANT'S CERTIFICATE

This is to certify that, James W. Byron who subscribed the statement hereon, is the person employed by the undersigned applicant to prepare this map, which has been adopted by the applicant as the approximate final location of the works thereby shown; and that this map is filed as a part of the complete application, and in order that the applicant may obtain the benefits of the act of March 4, 1911 (36 Stat. 1253; 43 U. S. C. 961), as amended,; and I further certify that the property herein described is desired for television relay station site.

_____

_____

Camas Valley Grange No. 521

Attest: _____

SURVEY TO MONUMENT PROPERTY CORNERS FOR T. V. RELAY STATION SITE IN LOT 4 OF SECTION 3, T. 30 S., R. 9 W. W. M.

SURVEYED OCT. 21, 1967 BY
JAMES W. BYRON SCALE AS SHOWN
SURVEYED FOR — CAMAS VALLEY GRANGE No 521

REGISTERED
OREGON
LAND SURVEYOR

James W. Byron

NOV. 6, 19[illegible]
JAMES W. BYRON
303