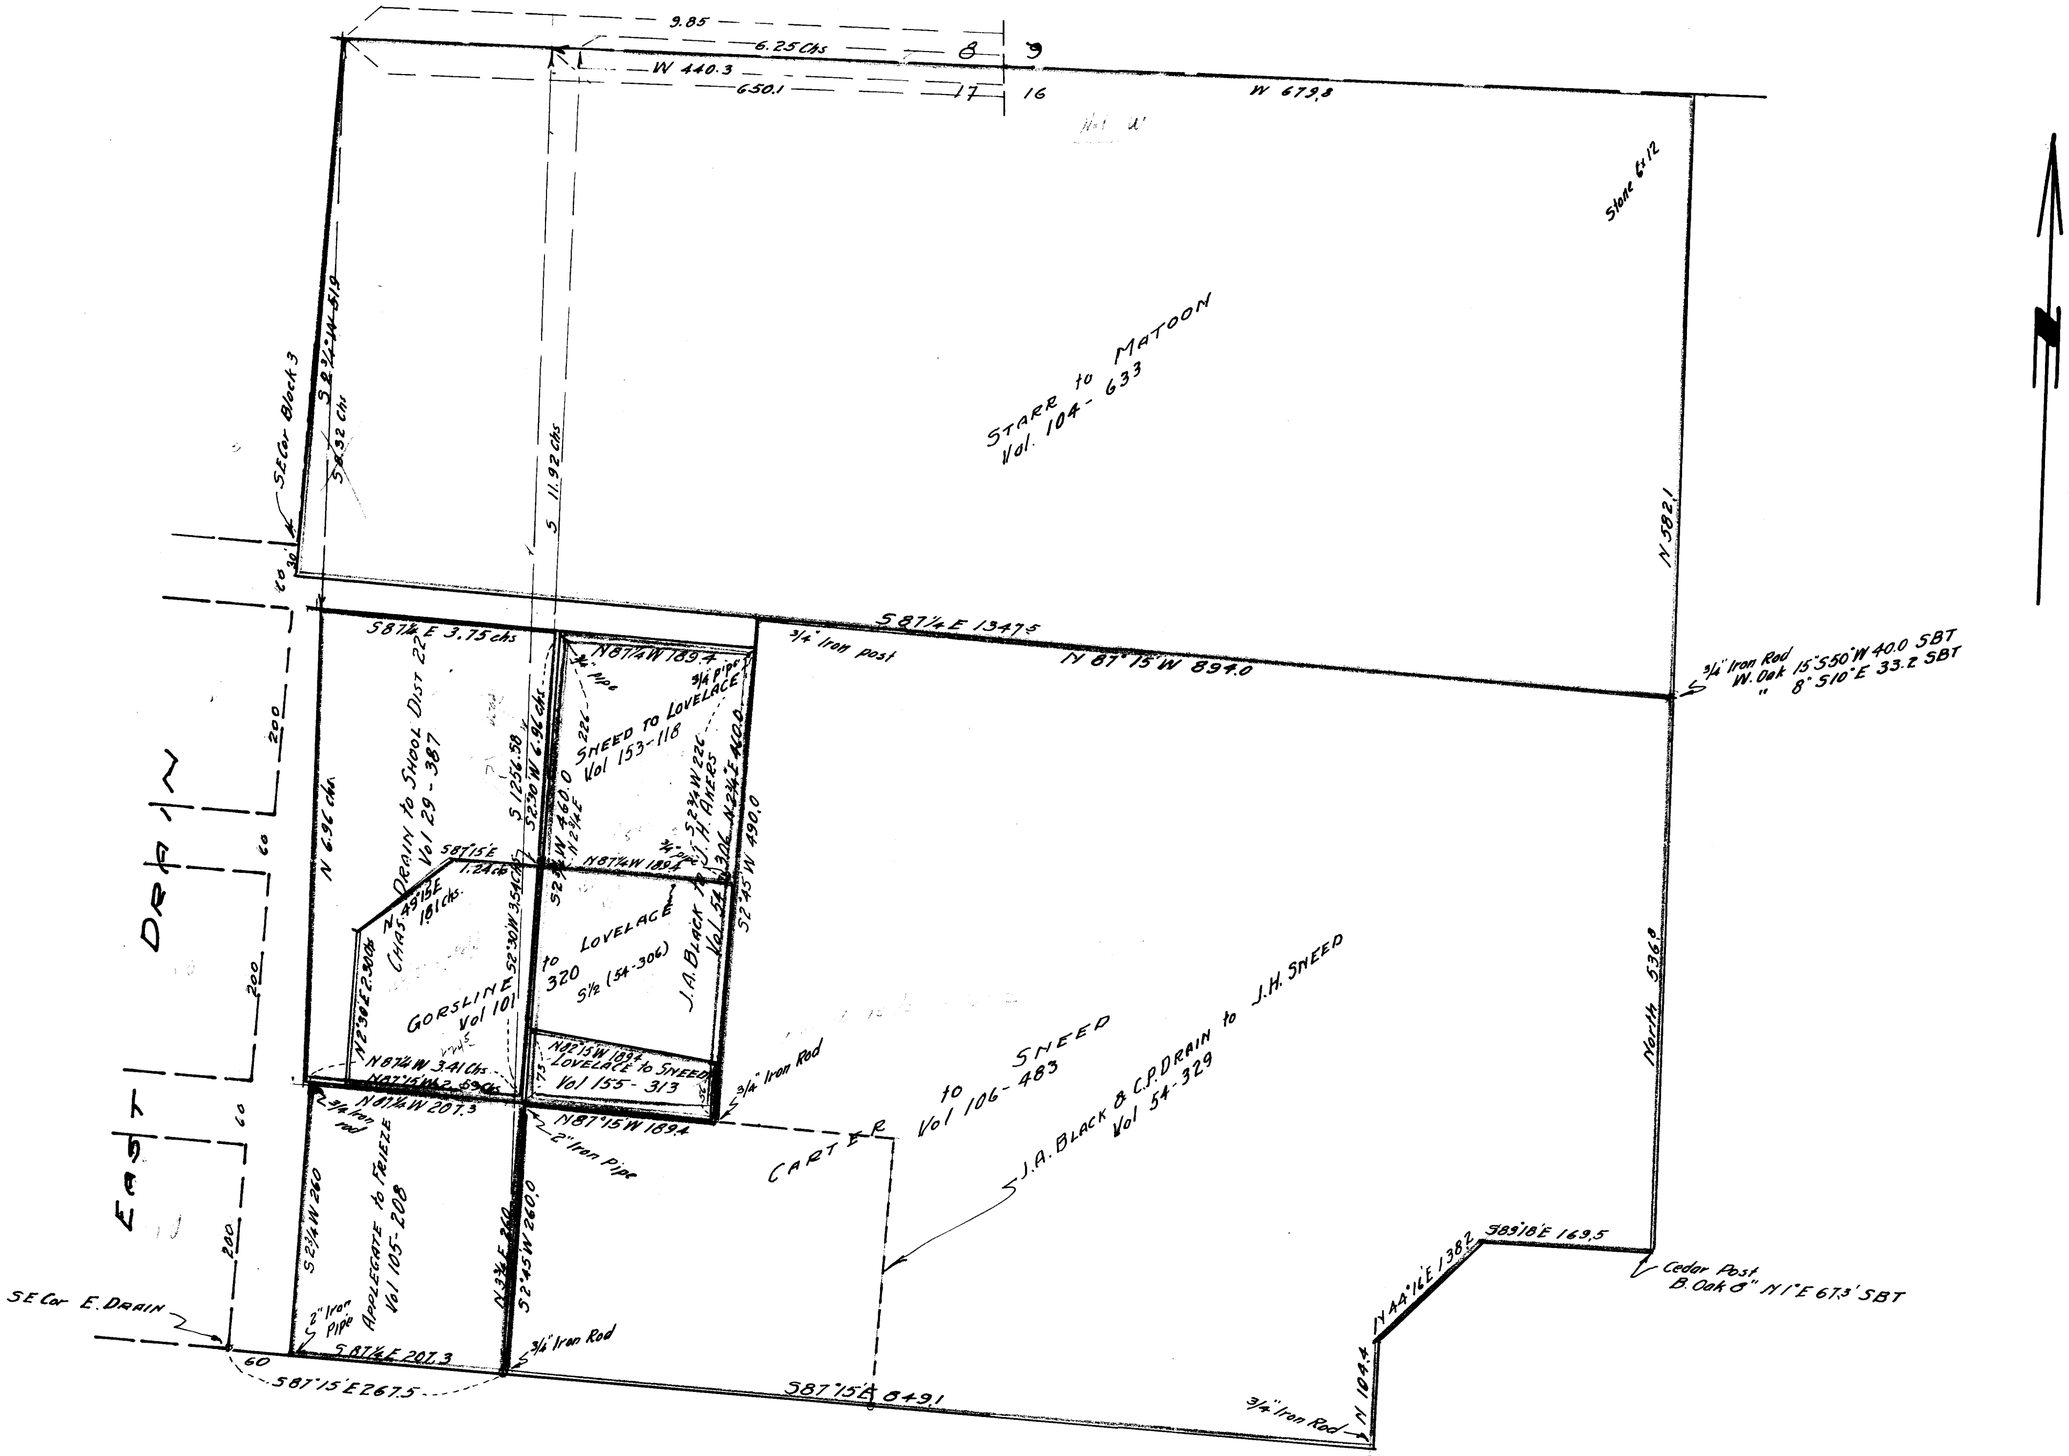

July 6, 1948.

SCALE 1" = 200'

PLAT OF LOVELACE AND ADJOINING DEEDS

T 22 S, R 5 W, WM. - DRAIN

Sec. 16 AND Sec. 17

DOUGLAS COUNTY OREGON

BEM. B. IRVING

County Surveyor

30.00 to Spring.

C. S. File No. 54/631