FILED
RECEIVED
JUN 15 1966
COUNTY SURVEYOR
DOUGLAS COUNTY, ORE.

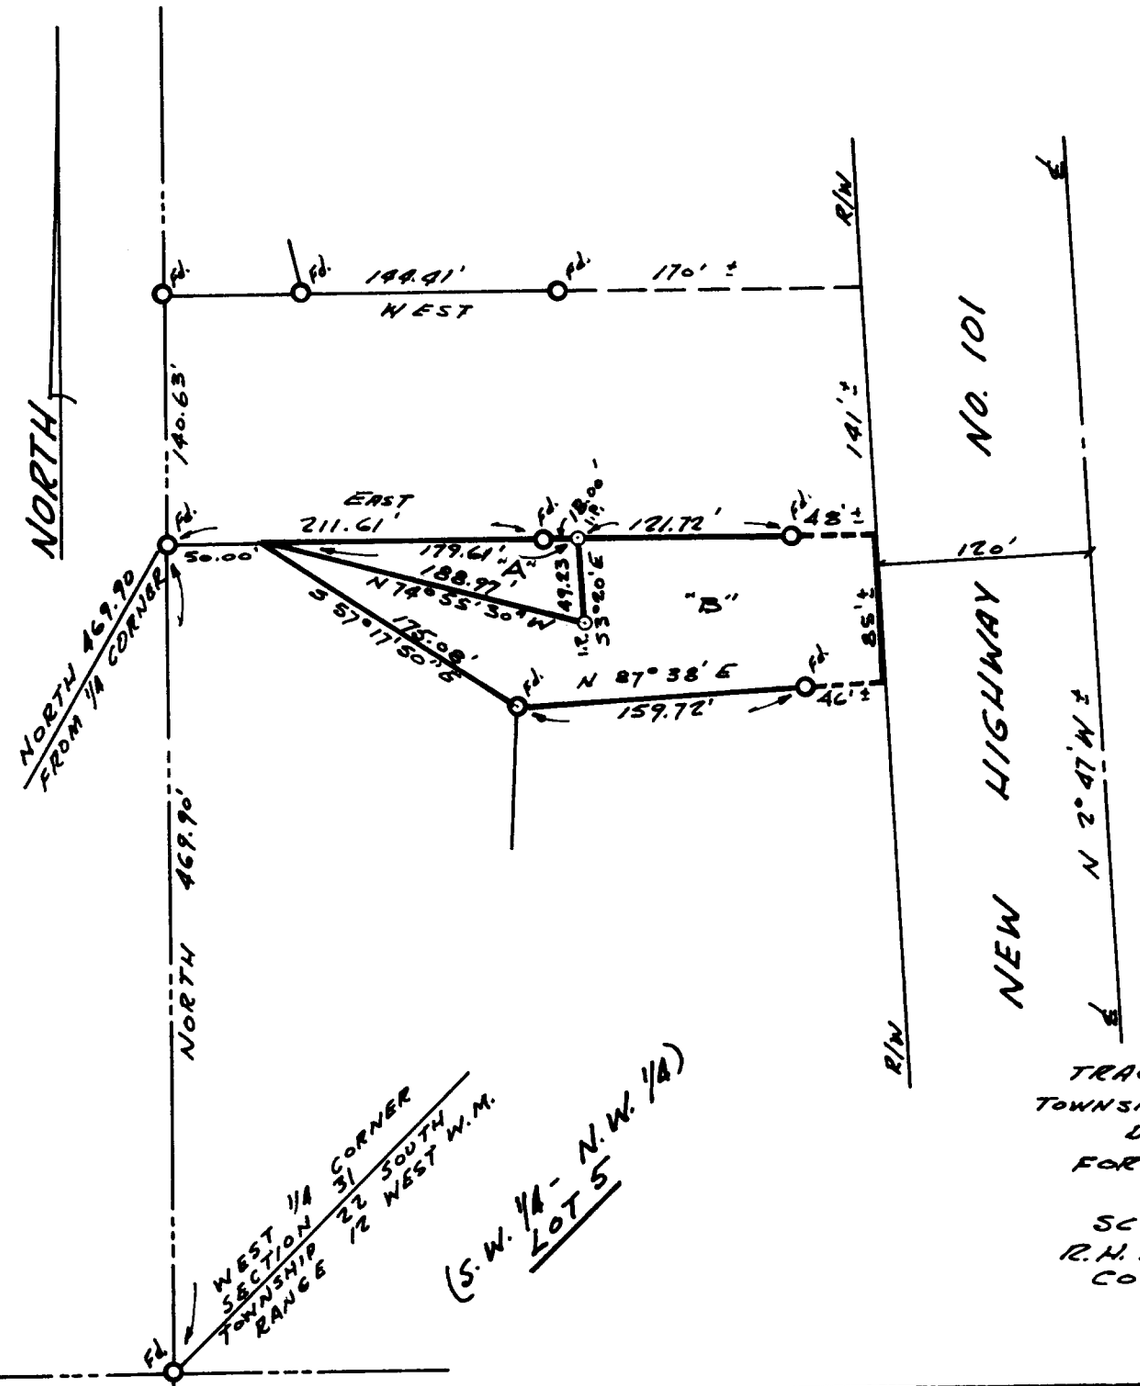

REGISTERED
OREGON
LAND SURVEYOR
Robert W. Wade
OCTOBER 4, 1957
ROBERT W. WADE
433

COUNTY SURVEYORS FILE DATA
DO NOT REMOVE FROM OFFICE

PROPERTY SURVEYS
TRACTS IN LOT 5, SECTION 31
TOWNSHIP 22 SOUTH, RANGE 12 WEST, W.M.
DOUGLAS COUNTY, OREGON
FOR MURYLE CHALLENDER

SCALE: 1" = 100' 3-16-66
R.H. ERICHSEN & ASSOCIATES
COOS BAY, OREGON

C. S. File No. 55/4-2