C. S. File No. 55/29-2

SURVEYED TO ESTABLISH PROPERTY LINE
A PORTION OF LOT 2, 3 & 4 BLK. A, HOOVER'S HOMES, SEC. 15, T. 28 S., R. 6 W.
SURVEYED FOR OSCAR A. & MARJORIE W. KNOPF
BY BAUGHMAN SURVEYING SERVICE
SCALE 1" = 60'
MARCH 14, 1967
• SET 5/8" IRON ROD

COUNTY SURVEYORS FILE DATA
DO NOT REMOVE FROM OFFICE

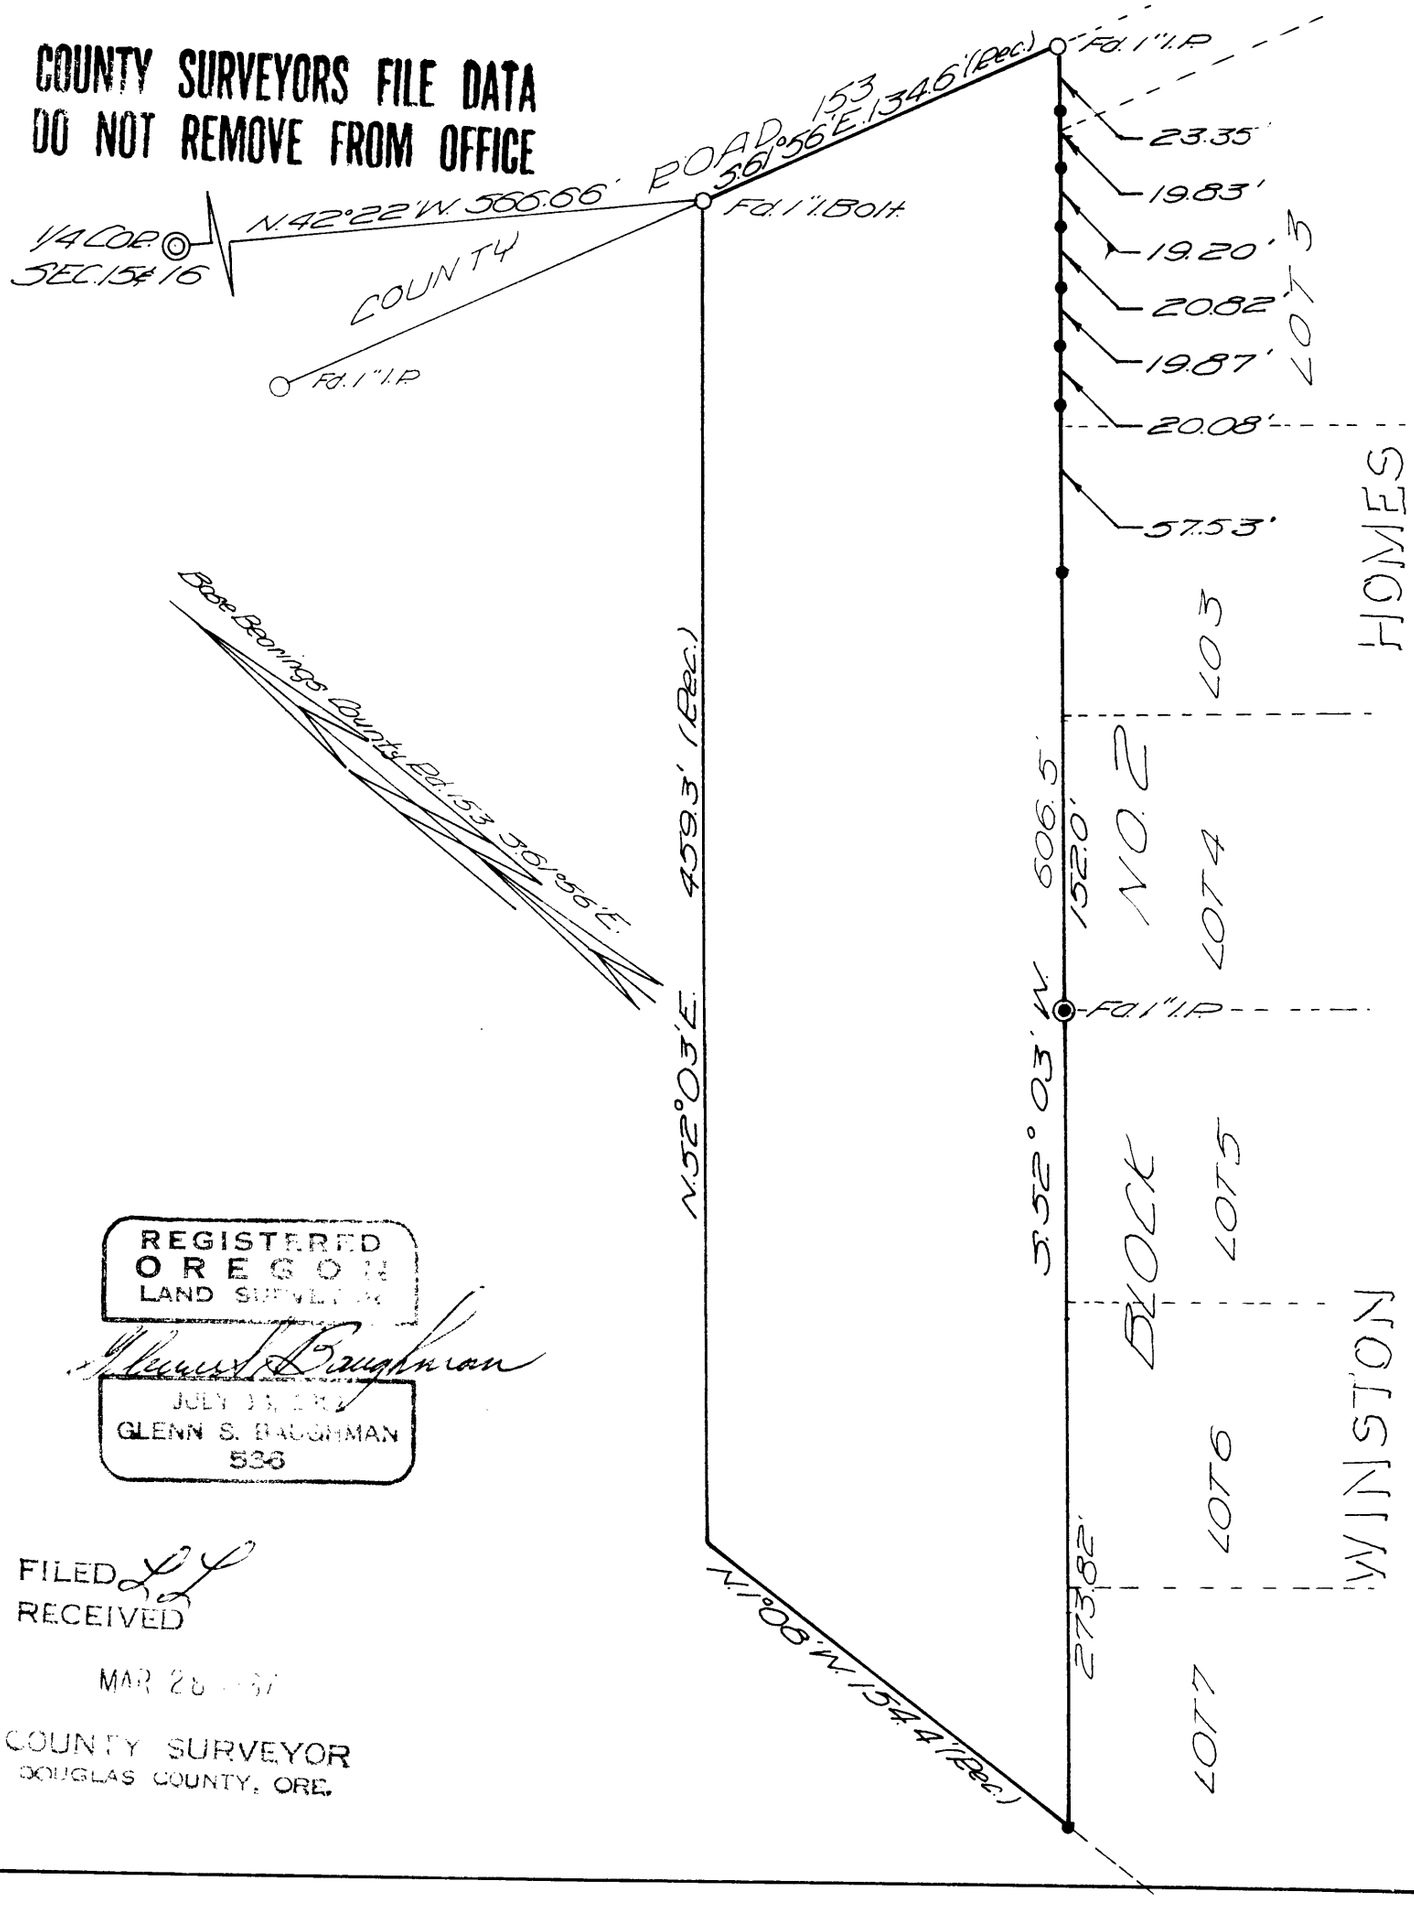


REGISTERED
OREGON
LAND SURVEYOR
JULY 13, 1962
GLENN S. BAUGHMAN
536

FILED
RECEIVED
MAR 28 1967
COUNTY SURVEYOR
DOUGLAS COUNTY, ORE.