REGISTERED
OREGON
LAND SURVEYOR

Louis Prahar

NOVEMBER 6, 1953
LOUIS B. PRAHAR
308

MAY 18, 1967

SCALE: 1 INCH = 60 FT.

COUNTY SURVEYORS FILE DATA
NOT REMOVE FROM OFFICE

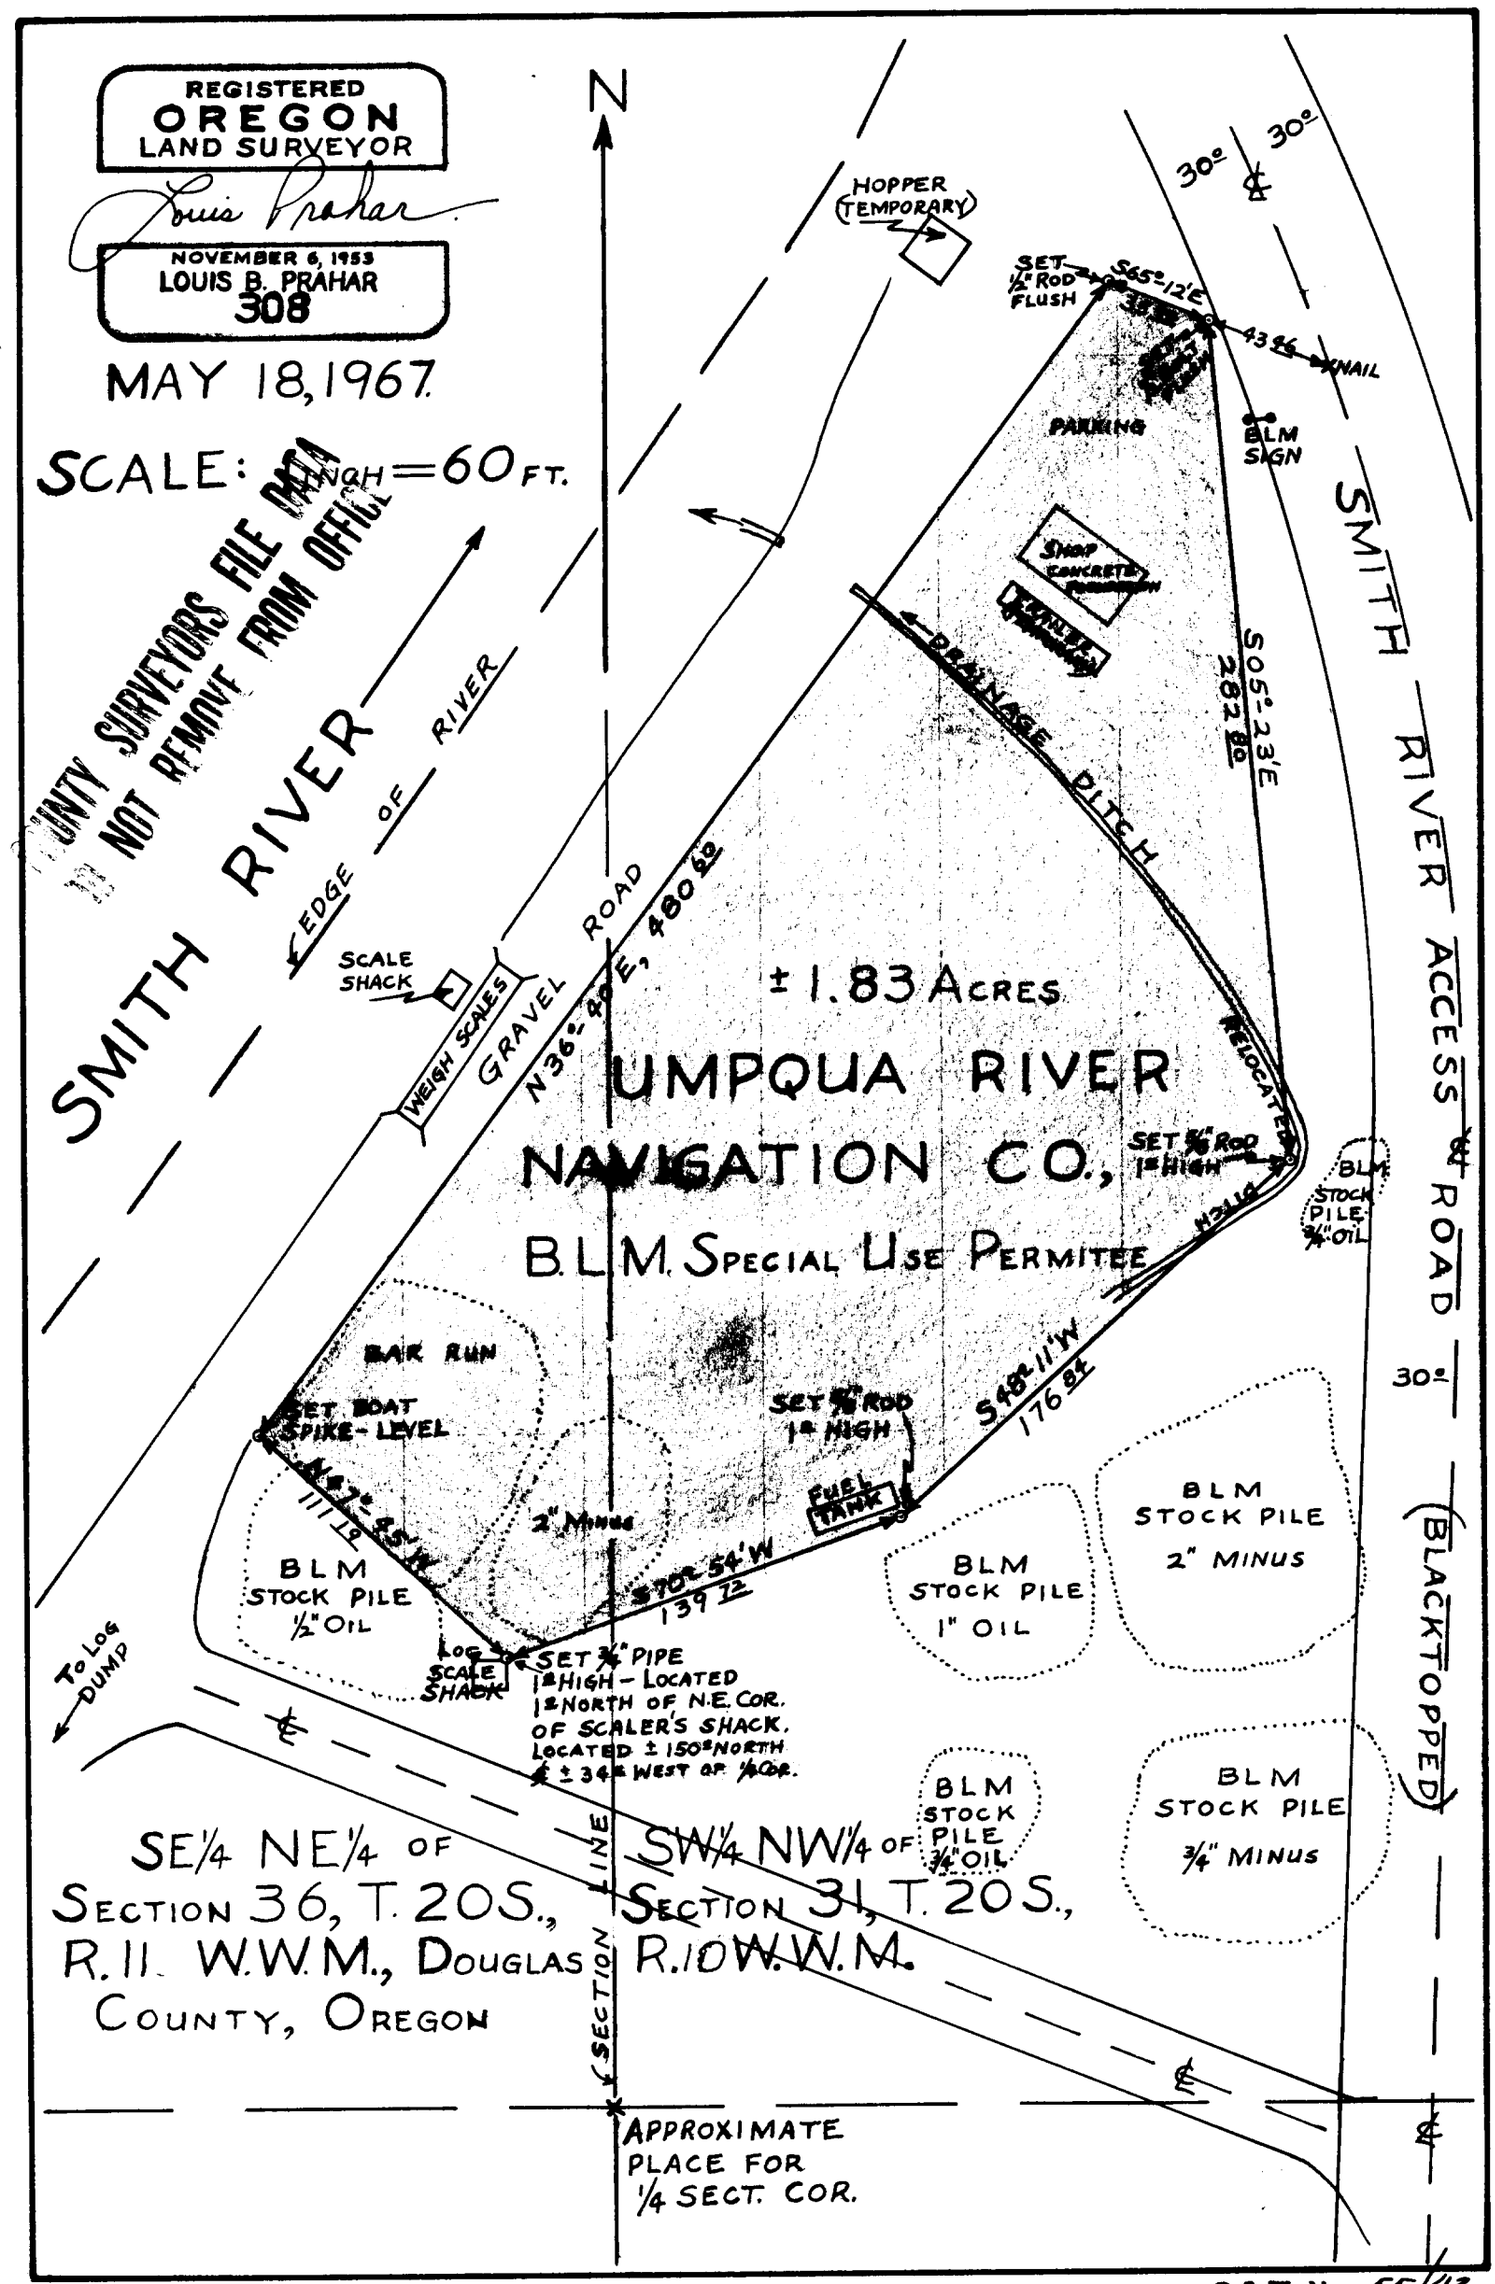

SE1/4 NE1/4 OF SECTION 36, T. 20S., R. 11 W.W.M., DOUGLAS COUNTY, OREGON

SW1/4 NW1/4 OF SECTION 31, T. 20S., R. 10 W.W.M.

P C. S. File No. 55/43