SURVEYED TO ESTABLISH PROP COR.

LOCATED IN SEC. 10, TWP 28S., R. 6 W.W.M.
(IN LOT 9, FISK FRUIT FARMS)
FOR F. M. BOYCE JULY 12, 1967
BY BAUGHMAN & ACKARET INC.
SCALE 1" = 50'

- SET 5/8" IRON ROD
- AS SHOWN

REGISTERED PROFESSIONAL ENGINEER 5588 OREGON JULY 8, 1966 ROBERT L. ACKARET

Robert L. Ackaret

FILED
RECEIVED
JUL 24 1967
COUNTY SURVEYOR
DOUGLAS COUNTY, ORE.

COUNTY SURVEYORS FILE DATA
DO NOT REMOVE FROM OFFICE

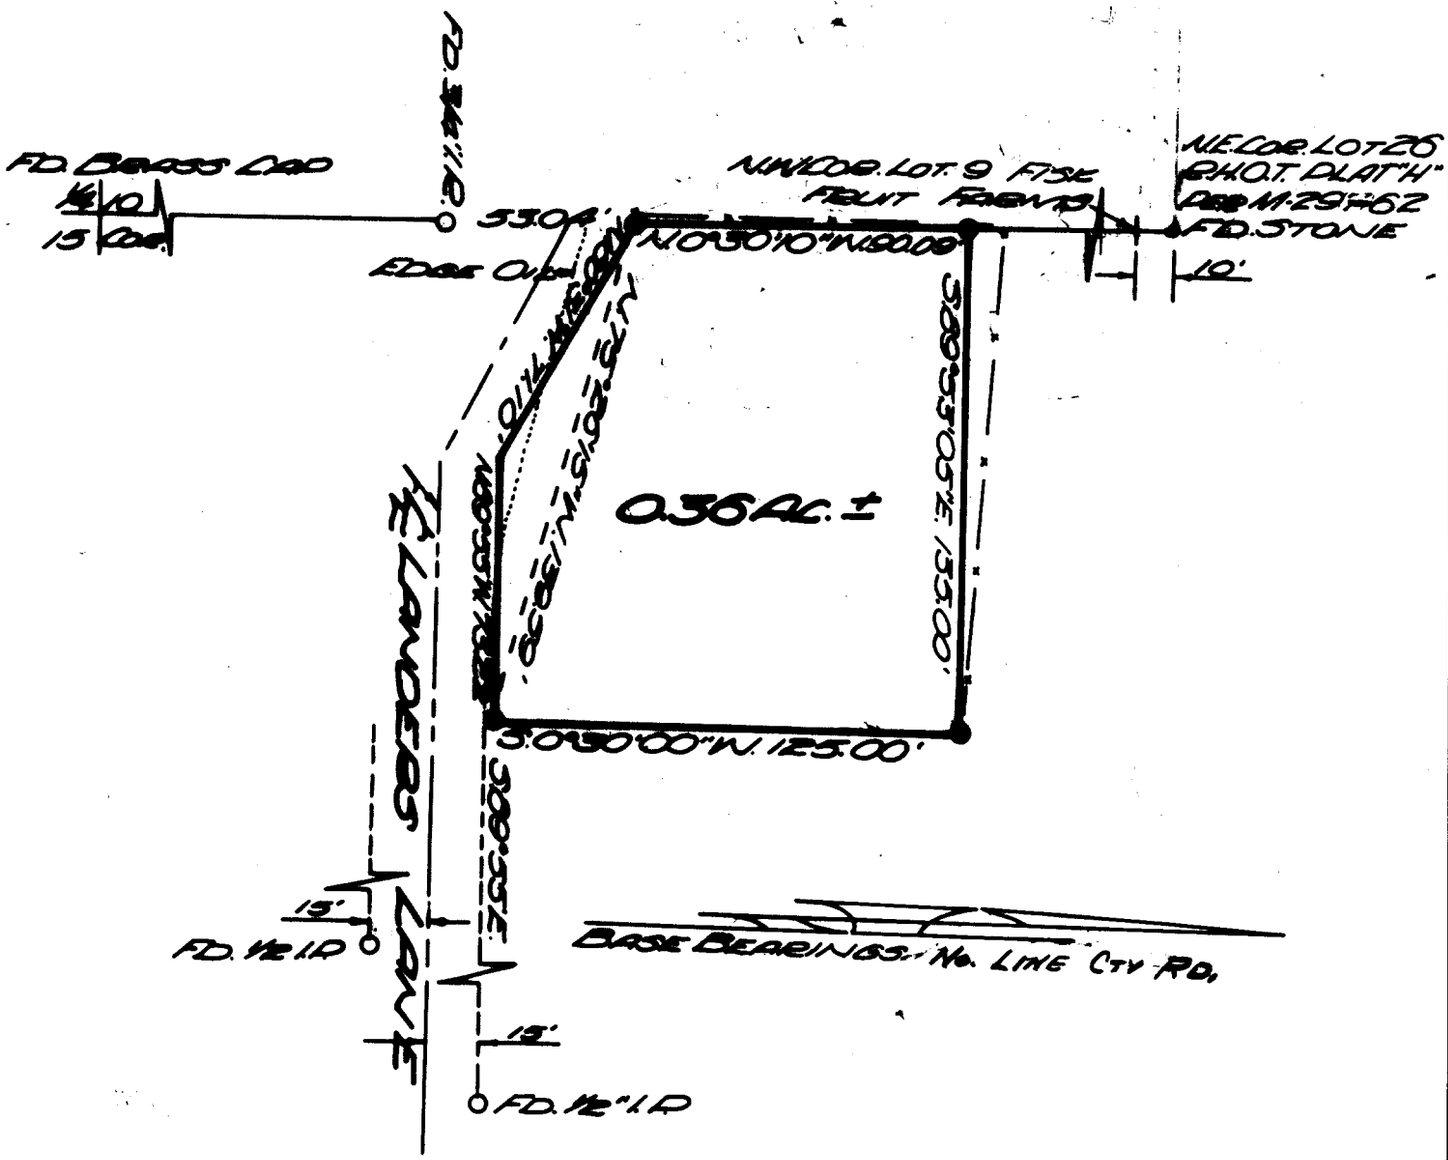

C. S. File No. 55/45-1