SURVEY IN SEC. 13, T24S, R7W, W.M.
Surveyed for Resort Properties Development Co.
Surveyed by Don E. Garrett
November 27, 1967
Scale 1" = 200'
•—Fd. 5/8" I. Rod ○—Set 5/8" I. Rod
For base of bearings see M 38-8

COUNTY SURVEYORS FILE DATA
DO NOT REMOVE FROM OFFICE

REGISTERED
OREGON
LAND SURVEYOR
Don E. Garrett
JULY 14, 1961
DON E. GARRETT
544

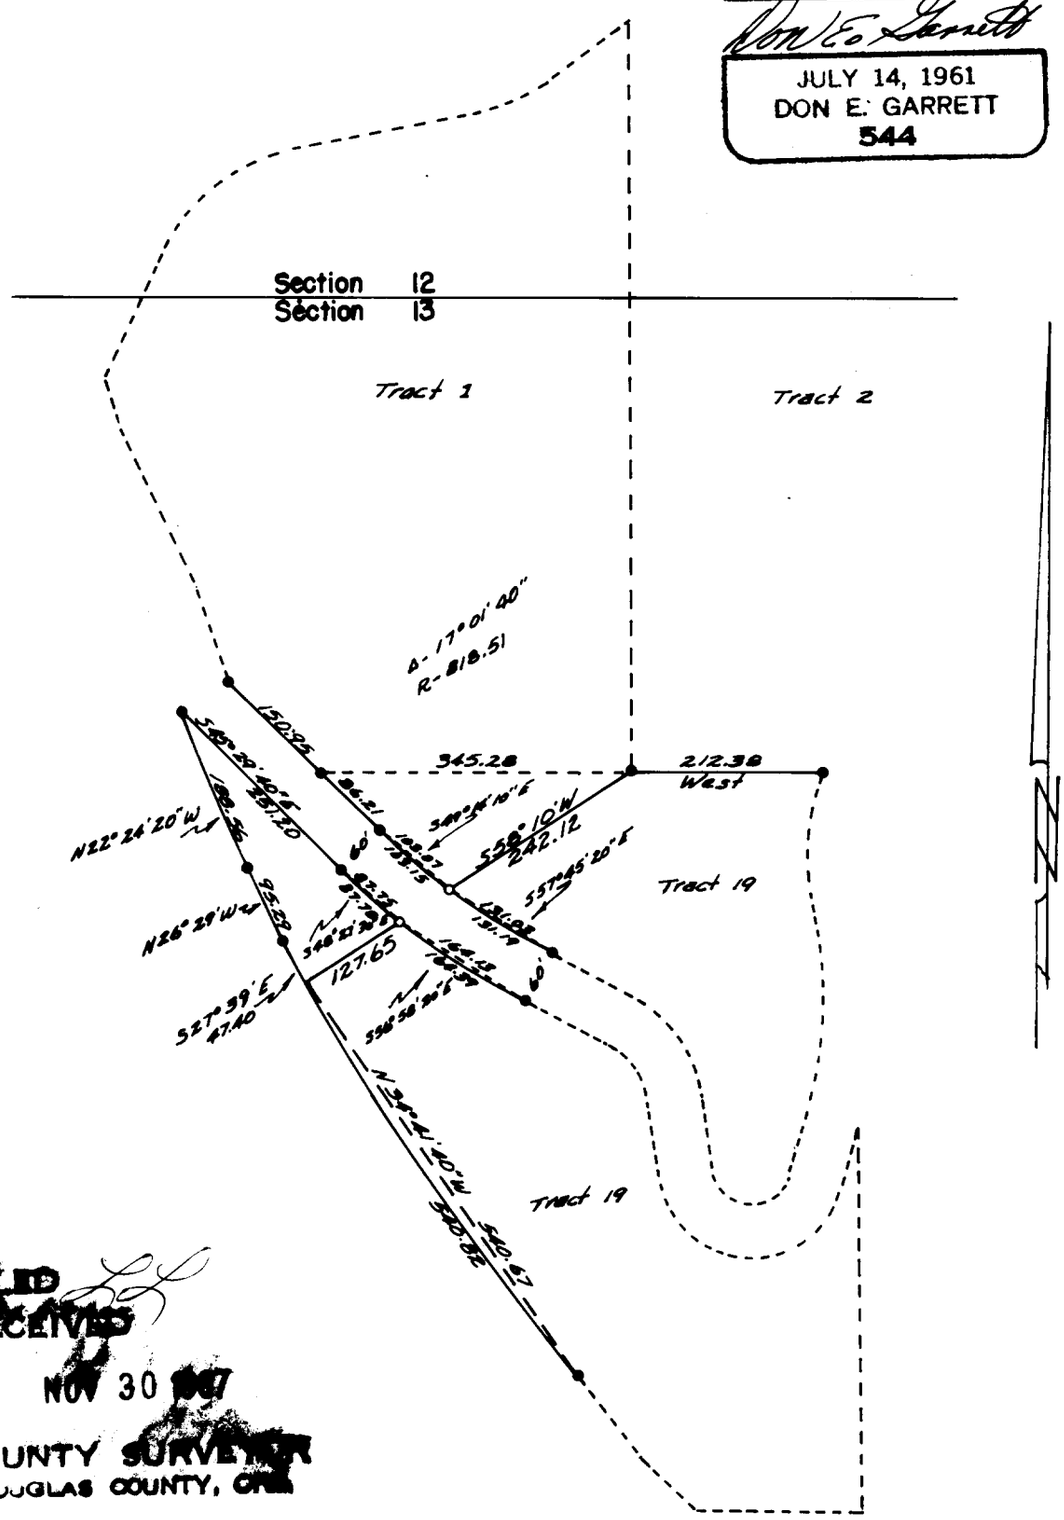

FILED
RECEIVED
NOV 30 1967
COUNTY SURVEYOR
DOUGLAS COUNTY, OREG.

C. S. File No. 55/46-3