SURVEY FOR DEED DESCRIPTION

IN SEC. 10, TWP 25S - R 4W. WM.
FOR CLARK GILKINSON NOV. 10, 1967
BY BAUGHMAN & ACKARET INC.
SCALE: 1" = 30'-0"

REGISTERED PROFESSIONAL ENGINEER 3580 OREGON ROBERT L. ACKARET

Robert L. Ackaret

COUNTY SURVEYORS FILE DATA
DO NOT REMOVE FROM OFFICE

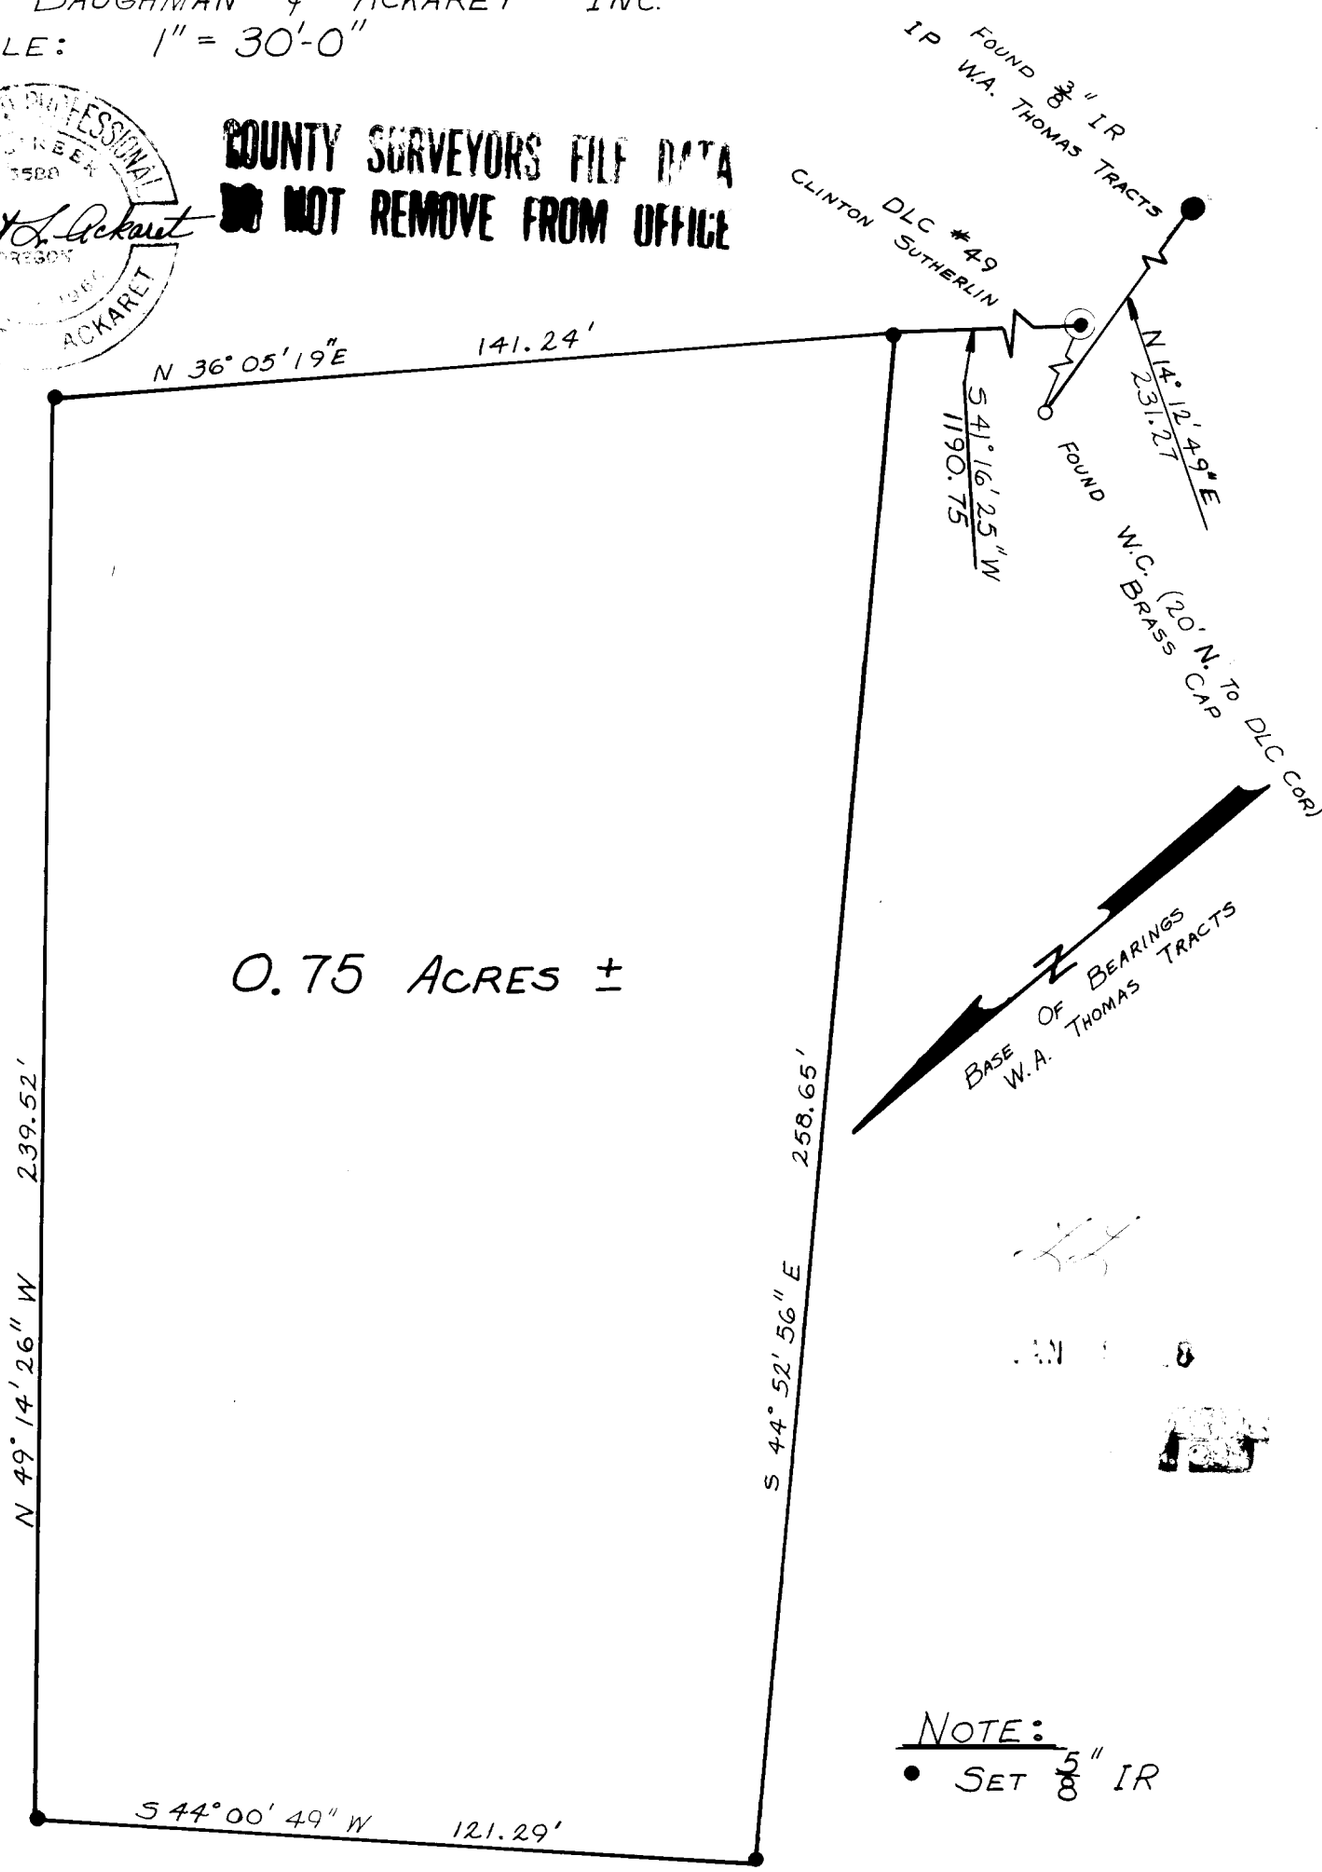

NOTE:
• SET 5/8" IR

55/58-1