SURVEY TO RESTORE PROPERTY CORNERS
LOCATED IN SEC. 23, T. 27 S., R. 6 W. W.M.
FOR FREE METHODIST CHURCH
BY BAUGHMAN & ACKARET INC. DEC. 1, 1967

COUNTY SURVEYOR'S FILE DATA
DO NOT REMOVE FROM OFFICE

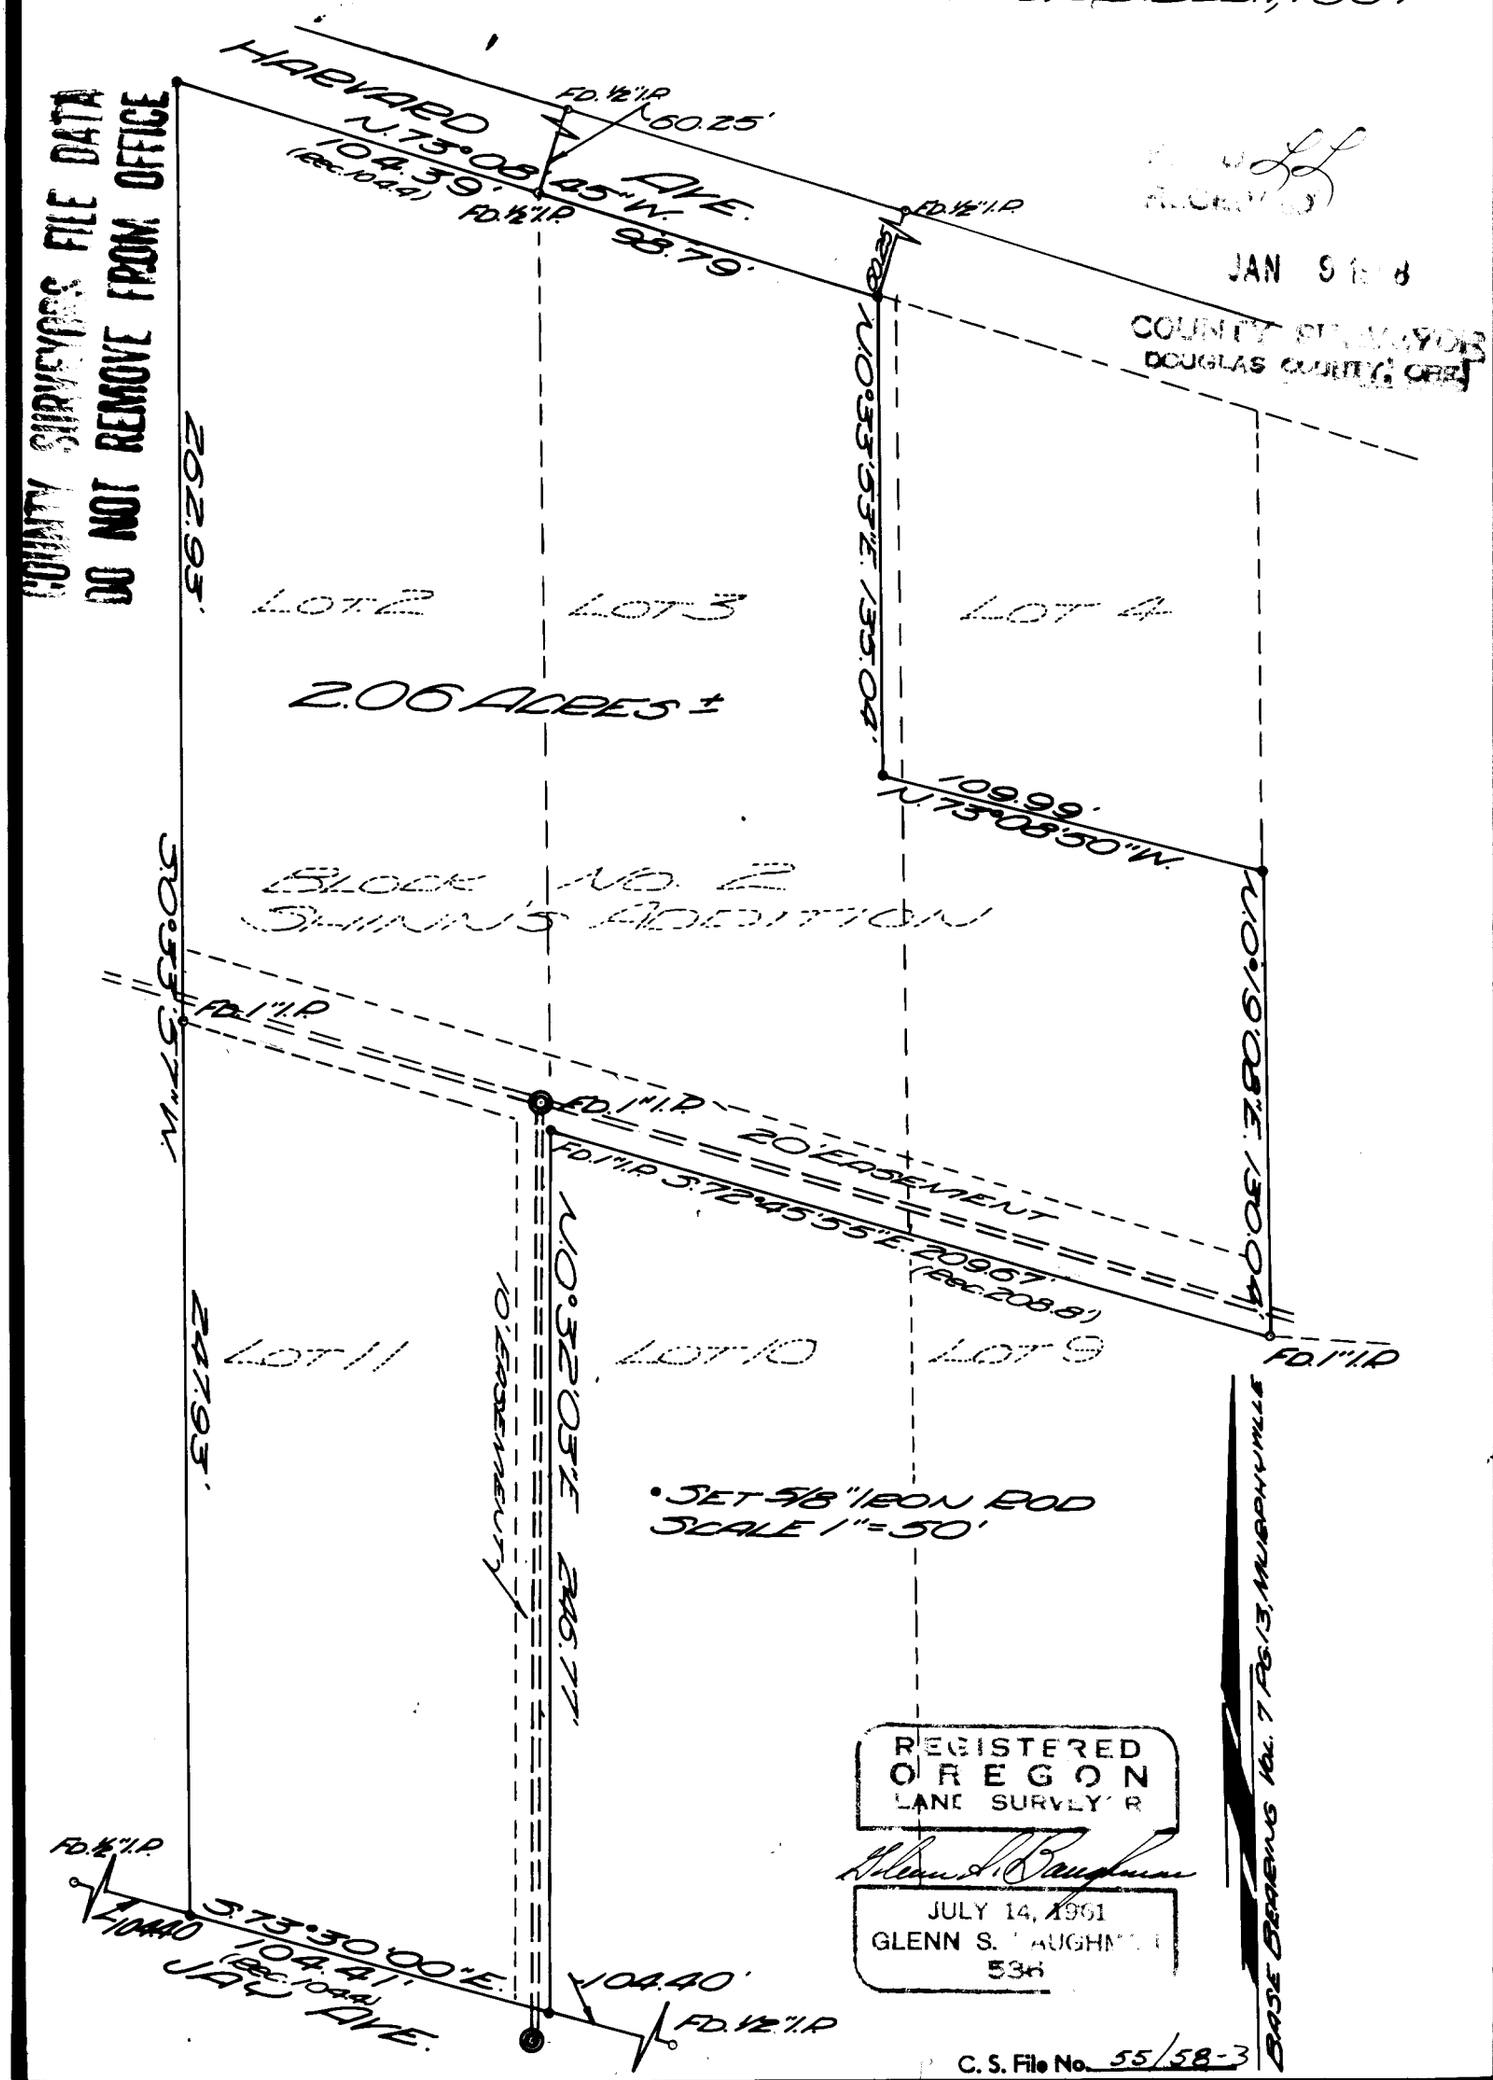

C. S. File No. 55/58-3