FILED
RECEIVED

JUN 4 1968

COUNTY SURVEYOR
DOUGLAS COUNTY, ORE.

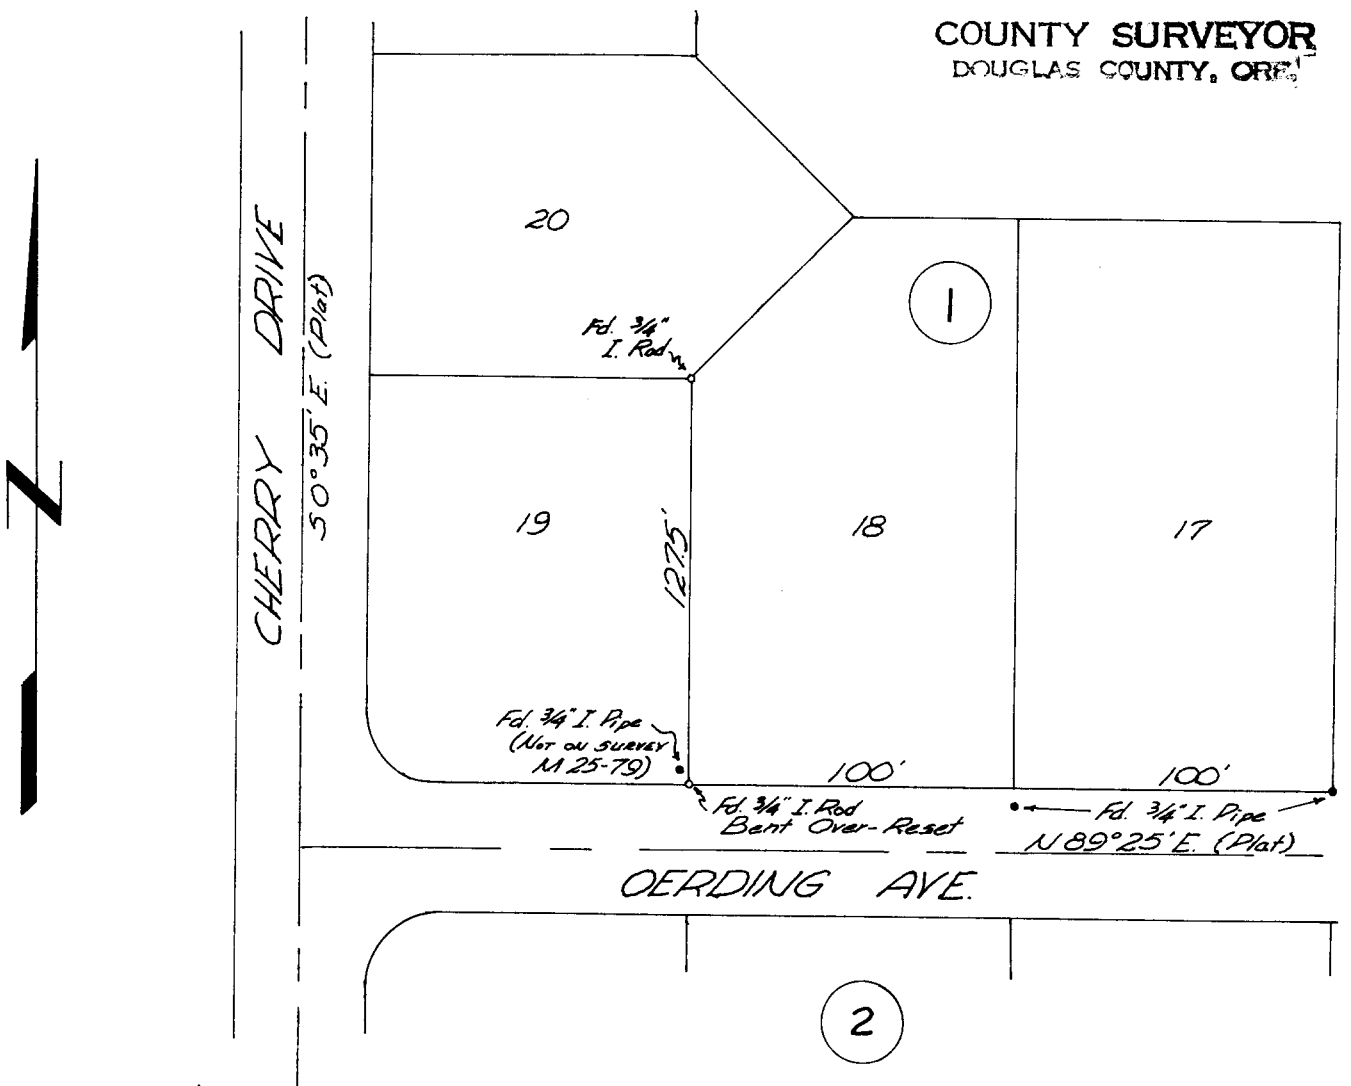

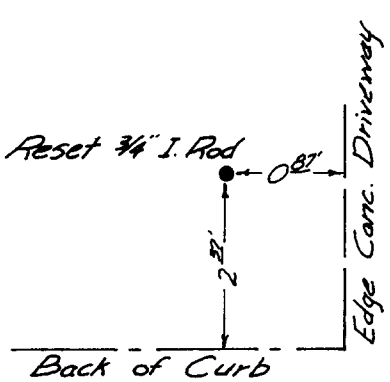

SURVEY OF LOT 18
BLOCK 1, GARDEN HOMES

SURVEY FOR RUSSELL PHILLIPS BY DON GARRETT
JUNE 1, 1968
SCALE 1"=60'

REGISTERED
OREGON
LAND SURVEYOR

Don E. Garrett

JULY 14, 1961
DON E. GARRETT
544

COUNTY SURVEYORS FILE DATA
DO NOT REMOVE FROM OFFICE

C. S. File No. 55/77-1