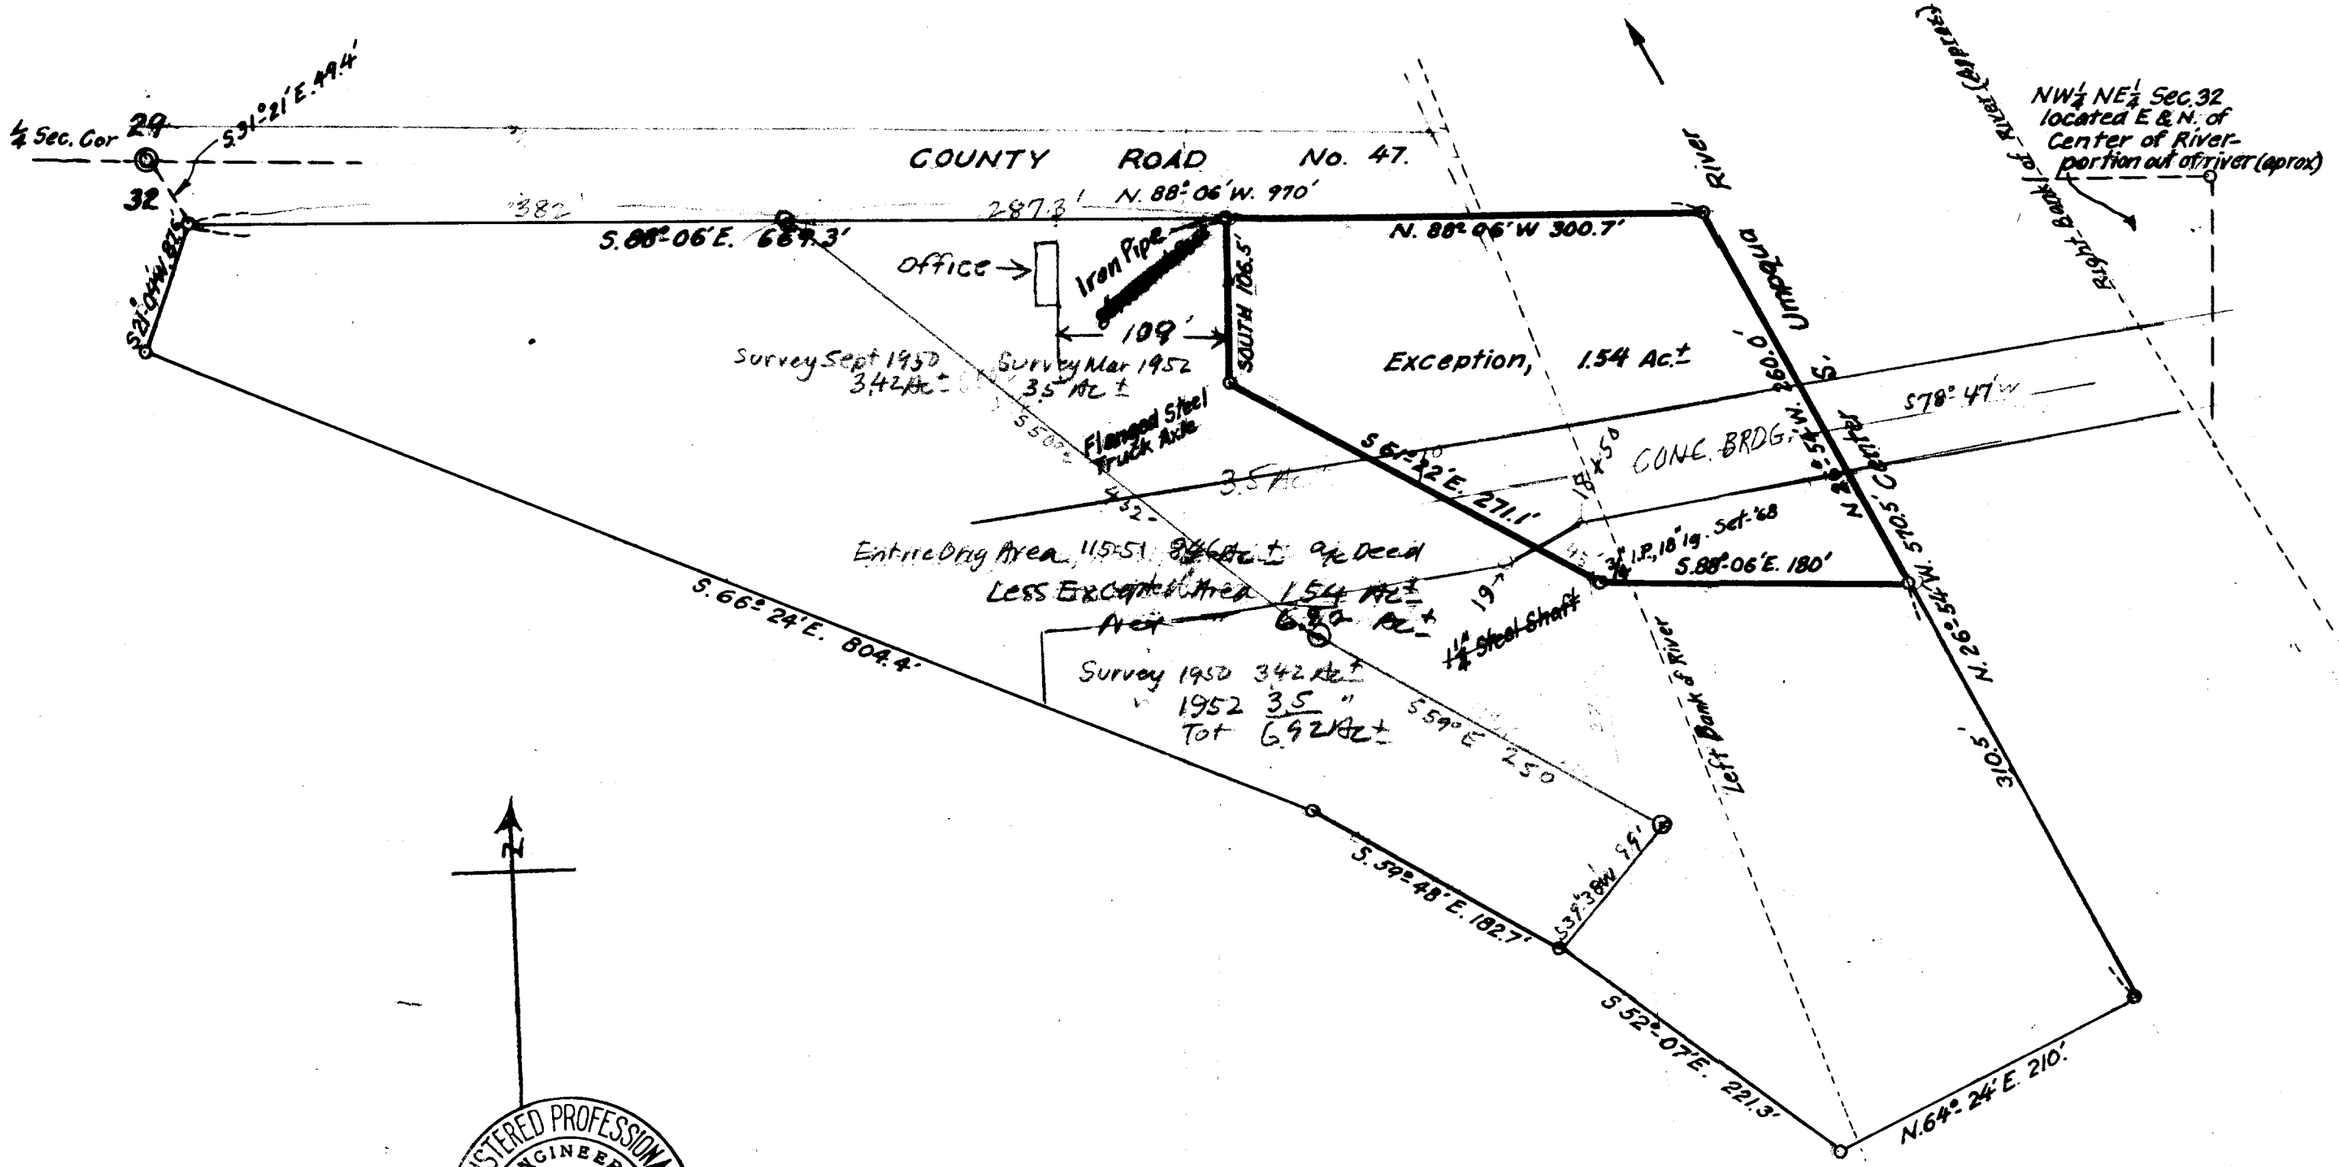

REGISTERED PROFESSIONAL ENGINEER 1581 OREGON MAY 5, 1933 ARTHUR BOYER

FILED
RECEIVED
JUN 17 1968
COUNTY SURVEYOR
DOUGLAS COUNTY, ORE.

COUNTY SURVEYORS FILE DATA
DO NOT REMOVE FROM OFFICE

AREA OF DEED RECORDED IN VOL. 115, PG. 51
SHOWING 1.54 ACRES ± EXCEPTED & RETAINED
BY STANFORD BUELL, DILLARD, ORE.
AREA IN SEC. 32, T. 28S; R. 6 W; W.M.

MAR 1952, June '68 AB.
JUNE 1959

1" = 100'

PACIFIC PL. File No. 55 / 78-2