N.W. Cor. DLC 52 Fd. Set Stone
12" Fir Bears N 85° E 12.5'
9" Fir Bears S 35° E 26.7'

COUNTY SURVEYORS FILE DATA
DO NOT REMOVE FROM OFFICE

SURVEY IN SECTION 20, TWP. 27 SOUTH, RNG. 7 WEST, W.M.

Surveyed for Hayward Reed by Don E. Garrett

September 1968 Scale 1" = 200'

⊙-Set 5/8" Iron Rod

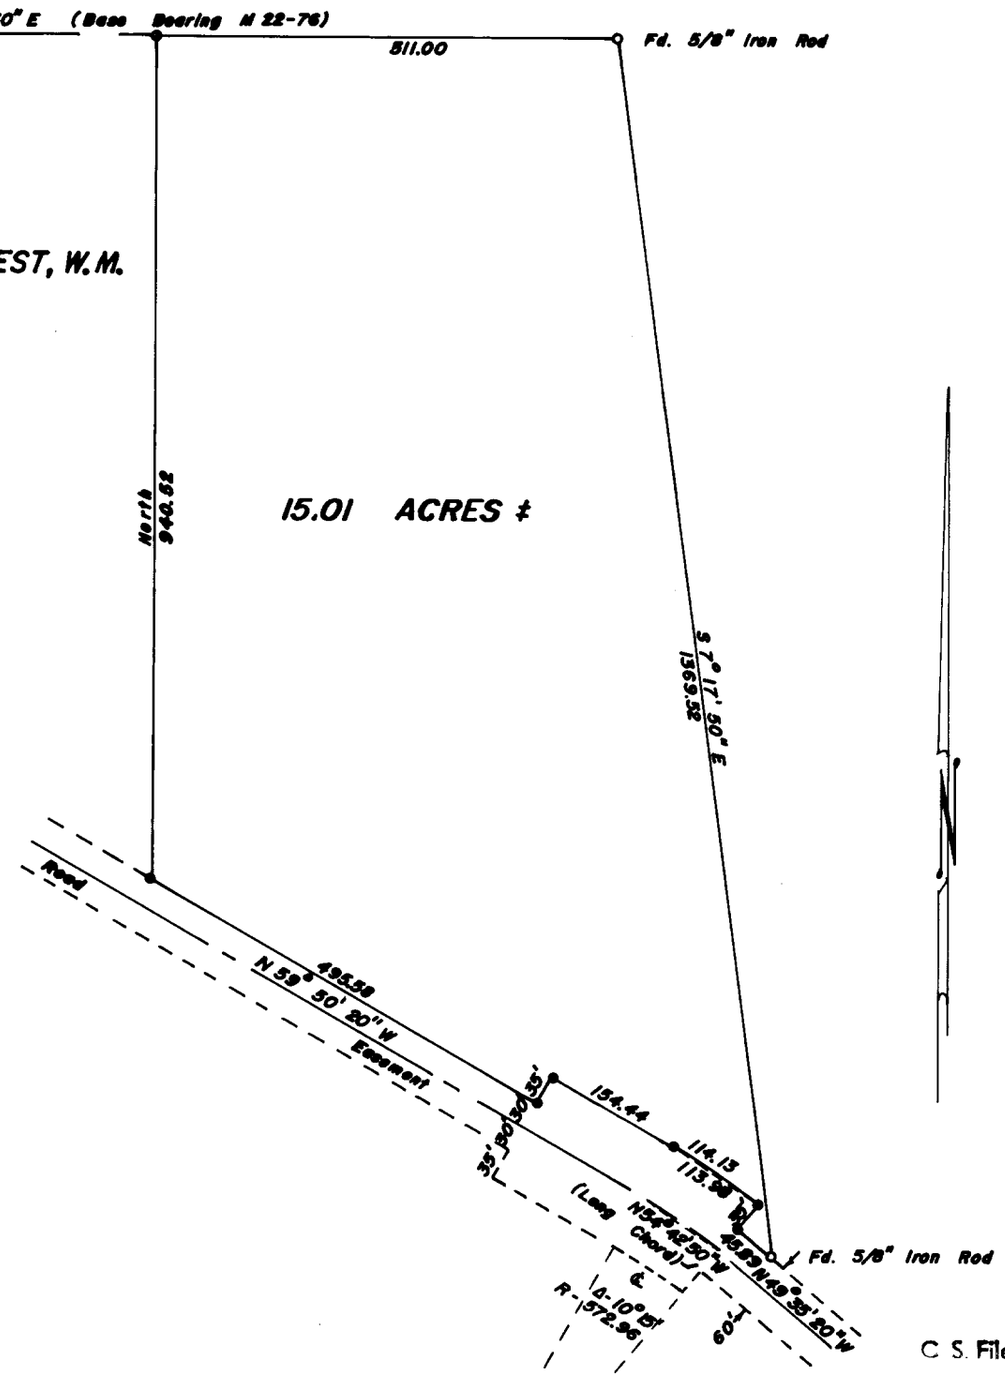

REGISTERED
OREGON
LAND SURVEYOR
Don E. Garrett
JULY 14, 1961
DON E. GARRETT
544

OCT 27 1968
COUNTY SURVEYOR

C. S. File No. 55/90-