SURVEY FOR DEED DESCRIPTION
PART OF LOT 18, 1ST ADD'N. TO EDEN ORCHARDS
DOUGLAS COUNTY, OREGON
SURVEYED FOR NORTHWEST PROPERTIES
by BRUCE R. ROGERS
OCT. 13, 1968
1" = 200'

COUNTY SURVEYORS FILE DATA
DO NOT REMOVE FROM OFFICE

Bearings & Proportioned Distances are based on a survey by Don E. Garrett.

∘ Fd. 5/8" Iron Rod
• Set 5/8" Iron Rod

RECEIVED
OCT 15 1968
COUNTY SURVEYOR
DOUGLAS COUNTY, ORE.

REGISTERED OREGON LAND SURVEYOR
Bruce R. Rogers
JULY 10, 1964
BRUCE R. ROGERS
660

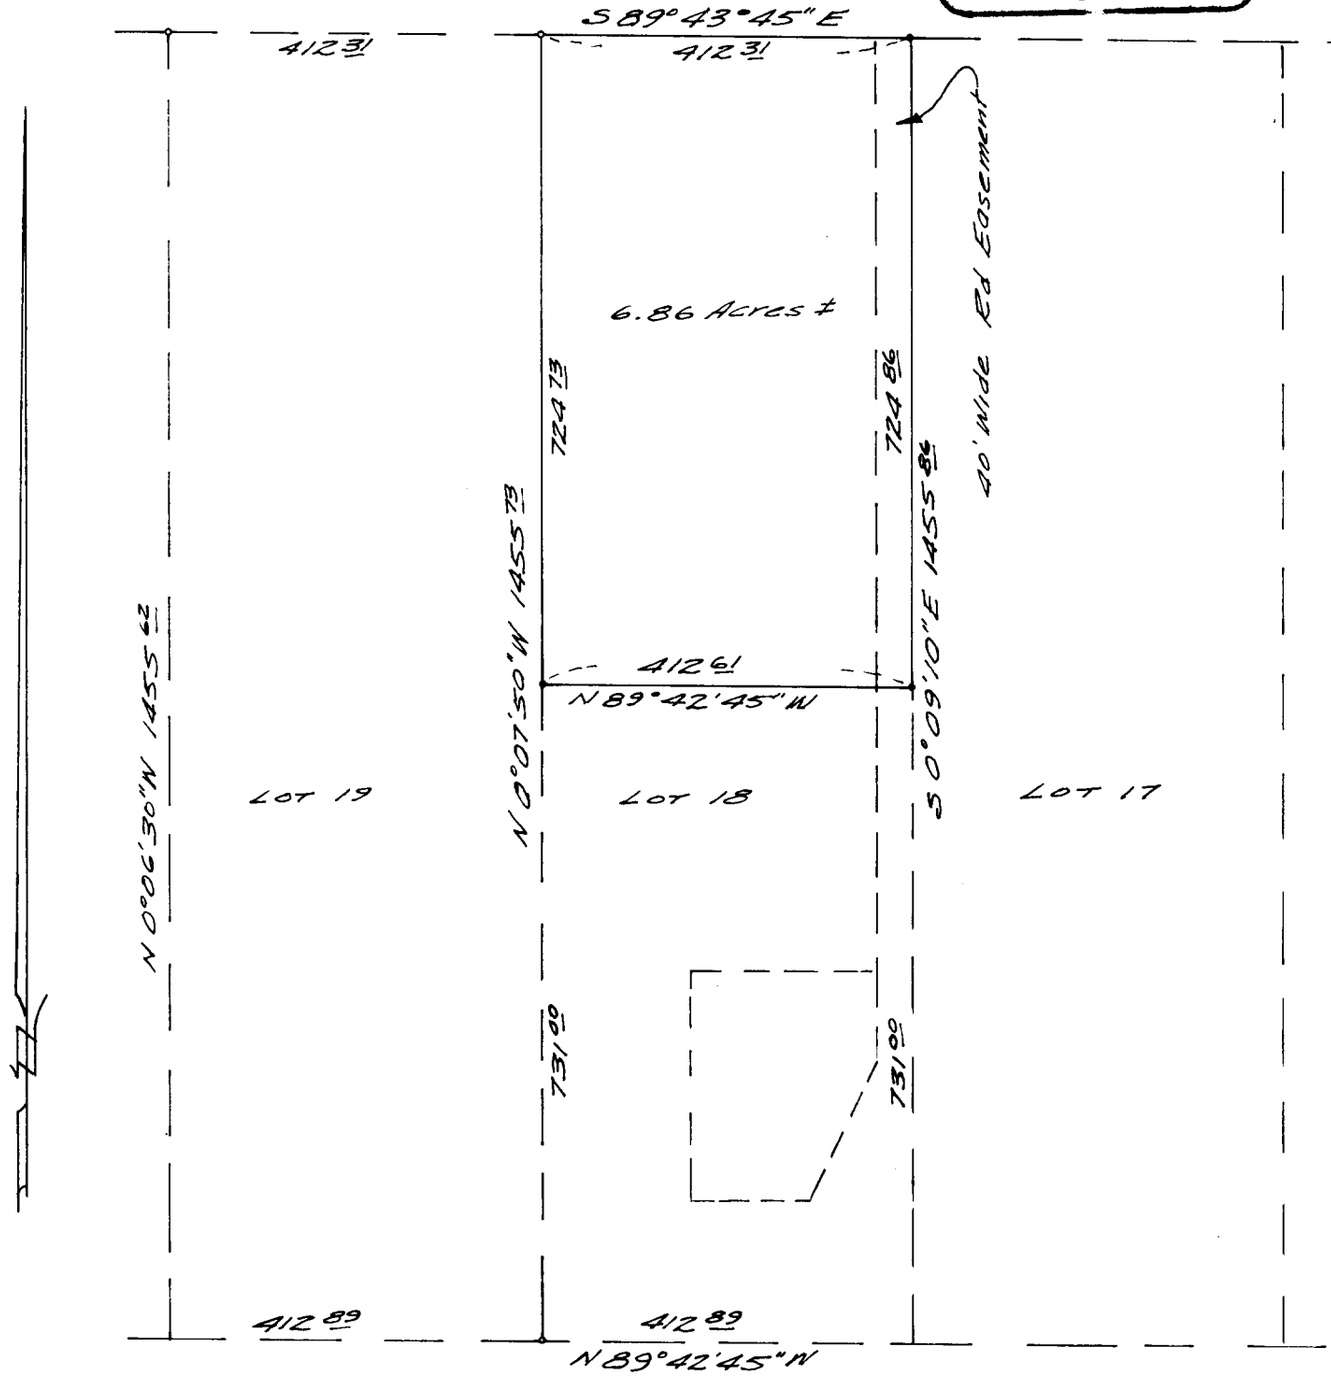

C. S. File No. 55/92 - 1