

RESTORED CORNER FOR STATE OF OREGON--DEPARTMENT OF FORESTRY

Section corner common to Sections 22, 23, 26 and 27, T22S, R12W, W.M., Douglas County, Oregon.

ORIGINAL

Fir Post (missing) from which a:

- 20" Cedar bears N37E 46 lks.; now 65" in place, face has been partially opened, no scribes visible.
- 10" Cedar bears S89E 117 lks.; missing.
- 10" Cedar bears S20W 100 lks.; now 32" windfall, face open, scribes 27 visible.
- 20" Cedar bears N50W 95 lks.; missing.

RESTORED


Set 1½" x 36" galvanized iron pipe with 3" bronze cap marked "OREGON STATE BOARD OF FORESTRY T22S R12W S22 S23 S26 S27 1969 RS 359", 34 inches in ground, and from which a:

- 65" Cedar (original) bears N37E 30.4 ft.; scribed RS 359.
- 17" Alder bears N40W 70.0 ft.; scribed T22S R12W S22 BT.
- 16" Alder bears S13E 32.2 ft.; scribed T22S R12W S26 BT.
- 8' x 15' Sandstone face bears S20½W 31.5 ft. to 8" X; scribed XBO.

Set 4" x 4" x 72" white painted Cedar post 2.4 ft. N60E of corner pipe. Oregon State Forestry Department metal location poster on Original Cedar N37E 30.4'.

Dated July 16, 1969.

Restored by Lloyd D. Smith under my direction.  
Lloyd D. Smith, Transitman

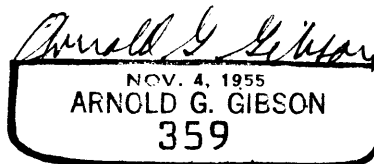

Present and witnessed by Charles W. Cook

FILED  
RECEIVED

SEP 9 1969

COUNTY SURVEYOR  
DOUGLAS COUNTY, ORE.

#58

C. S. File No. 55/101-10