

RESTORED CORNER FOR STATE OF OREGON--DEPARTMENT OF FORESTRY

One quarter corner for Section 26 (East Side), T22S, R12W, W.M., Douglas County, Oregon.

ORIGINAL

Hemlock Post (missing) from which a:

36" Fir bears N50E 10 lks.; missing.

36" Fir bears N05W 11 lks.; now 43" in place.

RESTORATION by Charles A. Slang, April 28, 1910.

(Original) hemlock post, destroyed marks on E side (now missing) from which a:

60" Fir bears N23W 11 lks.; now 63" in place.

10" Cedar bears S21W 26 lks.; now 12" in place, face partially closed, scribes 1/4 visible.

RESTORED

Set 1½" x 36" galvanized iron pipe with 3" bronze cap marked "OREGON STATE BOARD OF FORESTRY 1/4 S26 1969 RS 359", 34 inches in ground, and from which a:

11" Cedar bears S66½°E 14.6 ft. to face; scribed 1/4 S26 BT RS 359.


12" Cedar (original) bears S21°W 17.1 ft. to face; scribed BT.

Set 4" x 4" x 72" white painted Cedar post 1.6 ft. South of corner pipe. Oregon State Forestry Department metal location poster on 11" Cedar S66½°E 14.6 ft.

Dated July 16, 1969.

Restored by Lloyd D. Smith under my direction.
Lloyd D. Smith, Transitman

Present and witnessed by David H. Stere.

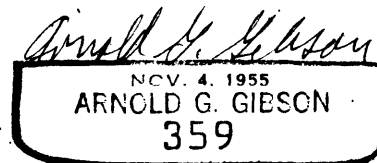

FILED
RECEIVED

SEP 9 1969

COUNTY SURVEYOR
DOUGLAS COUNTY, ORE.

#62

C. S. File No. 55/101-14