

Bearing Tree Renewals on  $\frac{1}{4}$  Cor. between Sec. 22 & 27,  
T 27S, R 7W. W.M.

Begin at the N.W. Section 27, T 27S, R 7W., W.M.

Fd. Brass cap - B.T.'s in good condition.

I ran East with transit and chain

magnetic declination =  $20^{\circ}00'$

At approximately  $\frac{1}{2}$  mile I found stone mound:

A 17" Blk. oak bears  $N 20^{\circ}W - 16.4$  ft.

Upper & lower faces chopped out and interior  
of tree rotted out.

Found no trace of S.W. B.T.

Brass cap at point of beginning bears  $S 89^{\circ}57'W$   
 $2636.00$  ft from stone mound.

New B.T.'s -


1. 8" white oak bears  $S 84^{\circ}E - 38^{\circ}$  ft.

Scribed " $\frac{1}{4}$  S 27 B.T."


2. 8" pine bears  $N 54^{\circ}30'W - 49^{\circ}$  ft.

Scribed " $\frac{1}{4}$  S 22 B.T."

Set oak Post in center of Rock mound at  
 $\frac{1}{4}$  Cor. location.

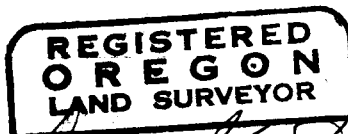

*Don E. Garrett*

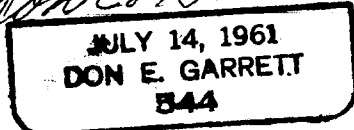

? - Did not record  
in book - Not enough  
evidence!

FILED  
RECEIVED

APR 3 1969

COUNTY SURVEYOR  
DOUGLAS COUNTY, ORE.