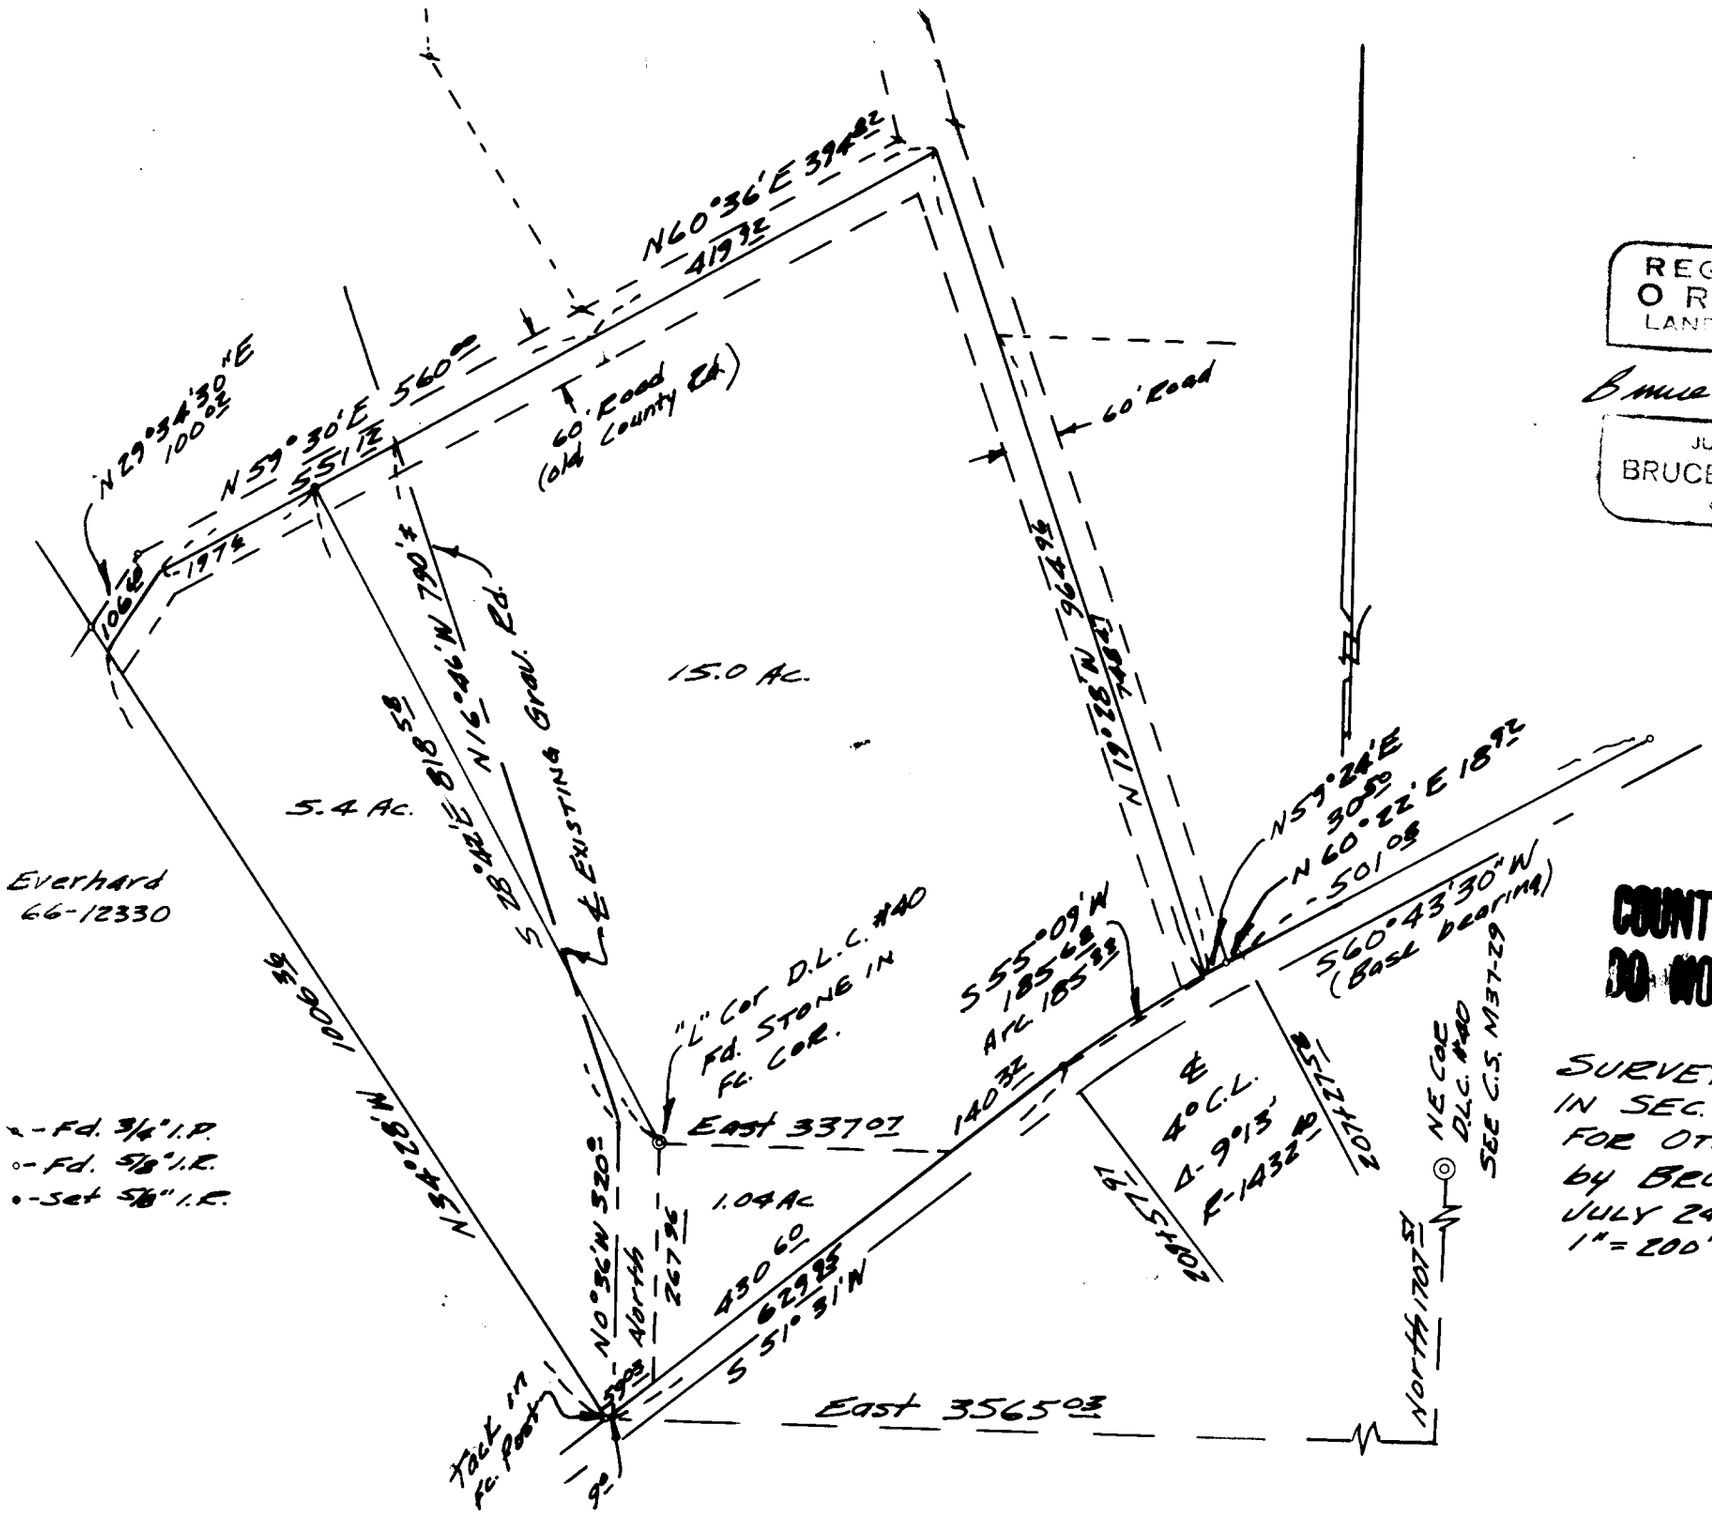

FILED
RECEIVED

JUL 24 1969

COUNTY SURVEYOR
DOUGLAS COUNTY, ORE

REGISTERED
OREGON
LAND SURVEYOR

Bruce R. Rogers

JULY 10 1968
BRUCE R. ROGERS
1660

COUNTY SURVEYORS FILE DATA
DO NOT REMOVE FROM OFFICE

SURVEY FOR DEED DESCRIPTION
IN SEC. 6 & 7, T. 28S., R6 W.W.M.
FOR OTIS HELMAN
by BRUCE R. ROGERS
JULY 24, 1969
1" = 200'

P C.S. File 55/119-