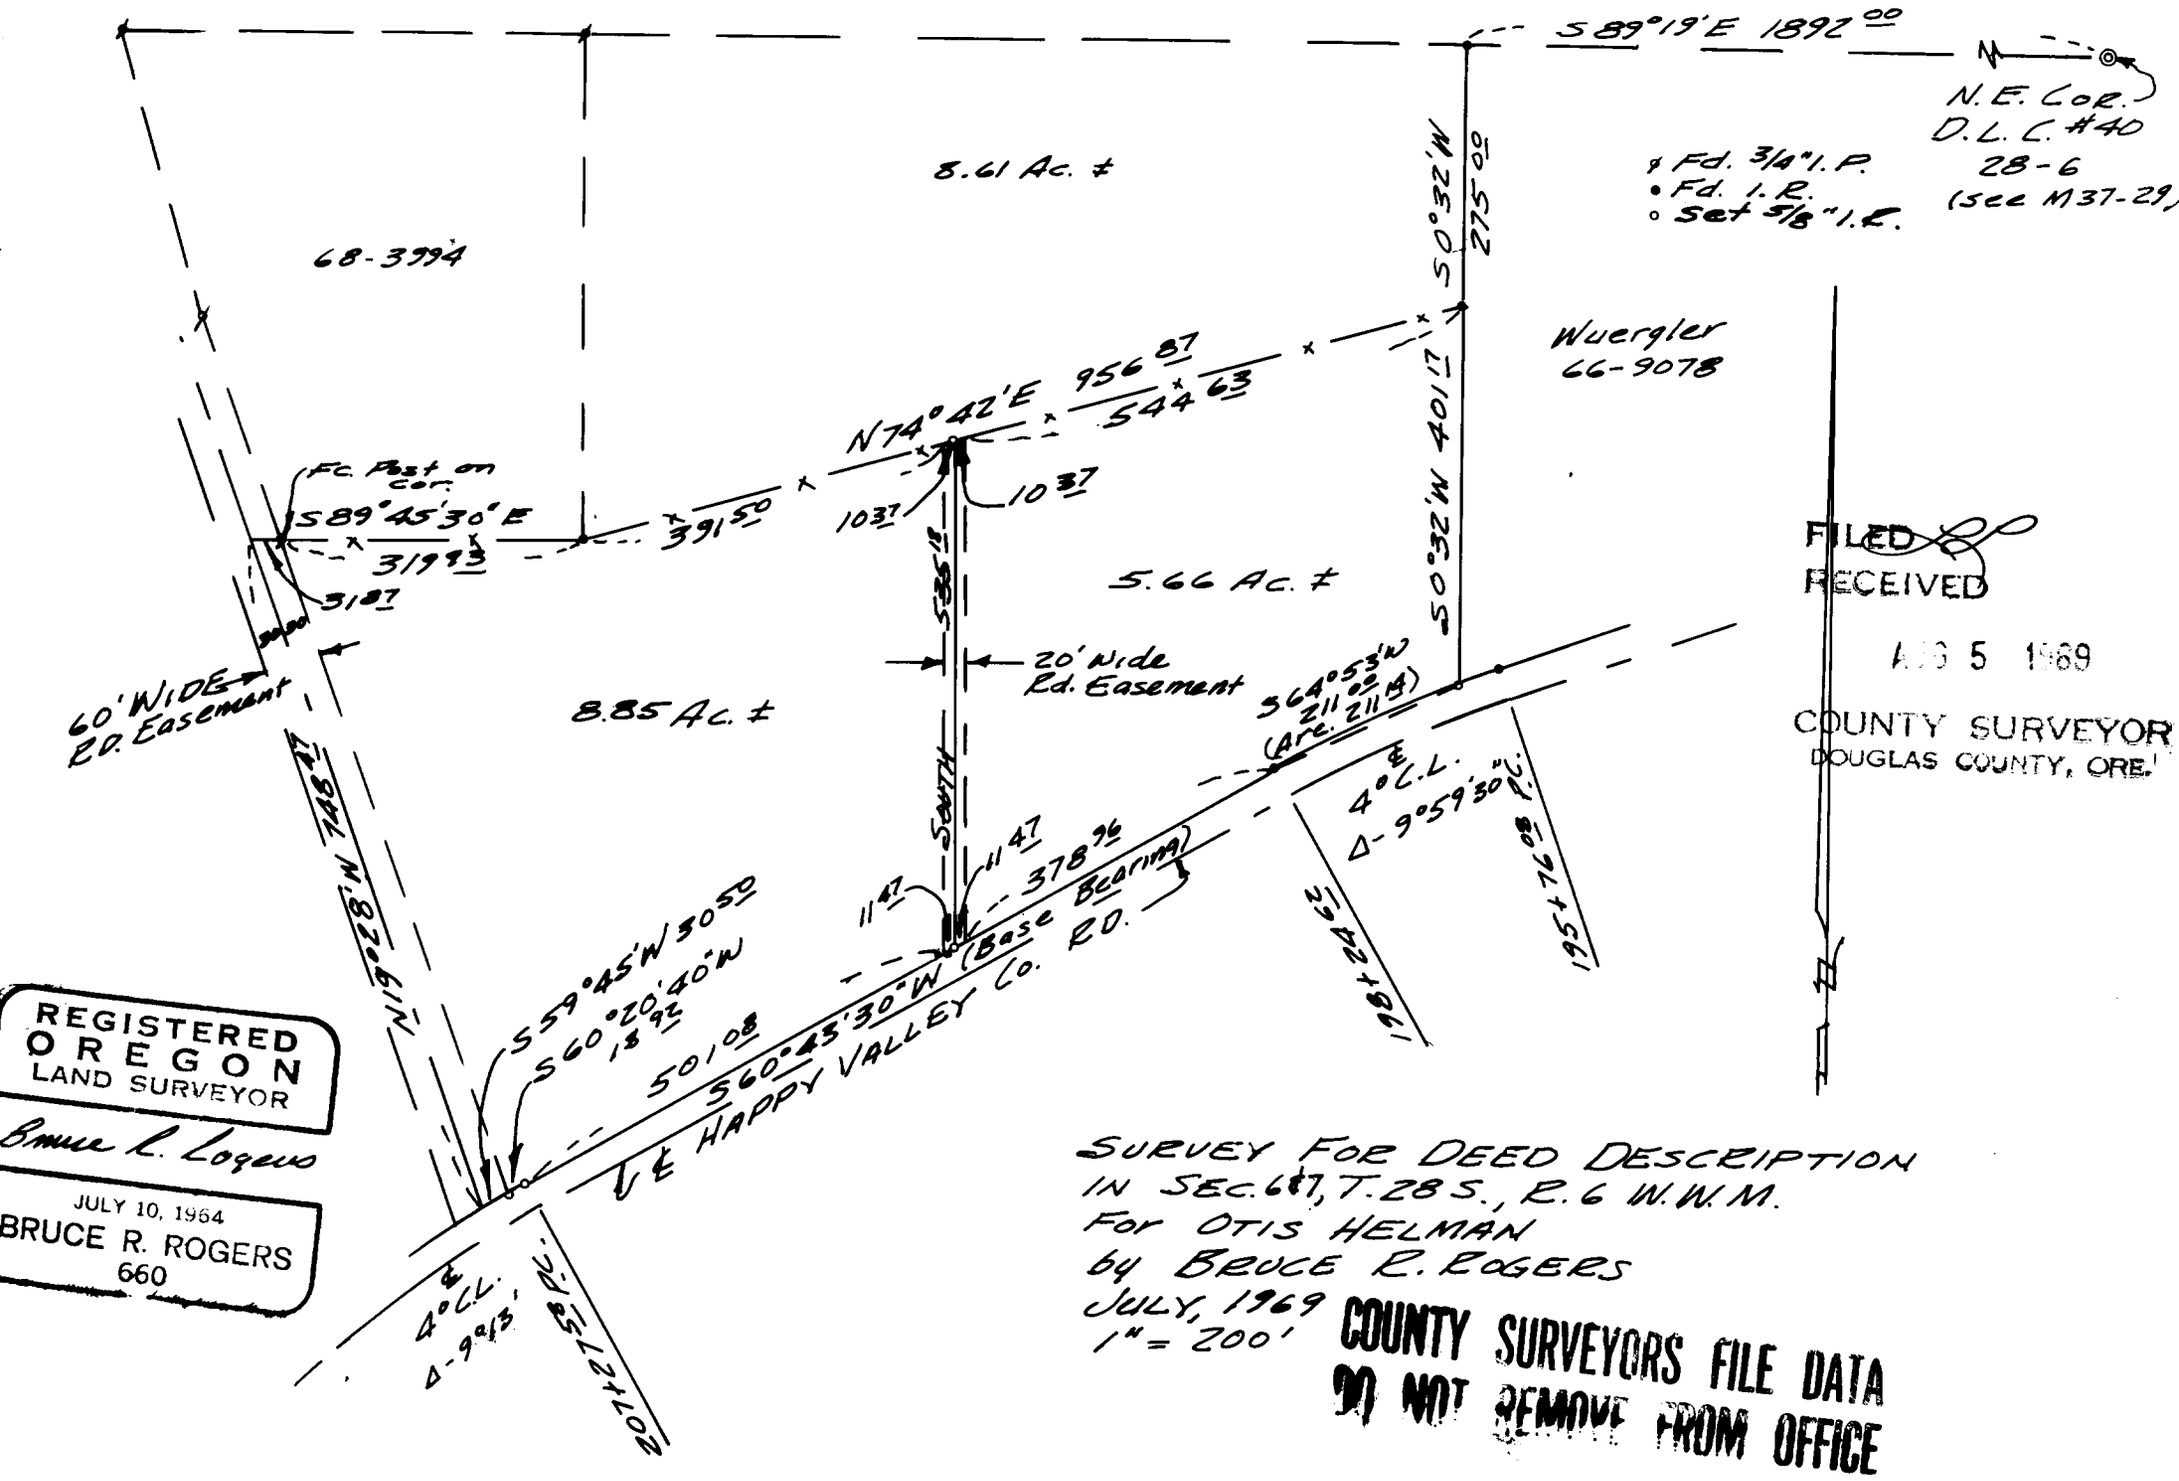

REGISTERED
OREGON
LAND SURVEYOR
Bruce R. Rogers
JULY 10, 1964
BRUCE R. ROGERS
660

SURVEY FOR DEED DESCRIPTION
IN SEC. 6, T. 28 S., R. 6 W.W.M.
FOR OTIS HELMAN
by BRUCE R. ROGERS
JULY, 1969
1" = 200'

FILED
RECEIVED
AUG 5 1969
COUNTY SURVEYOR
DOUGLAS COUNTY, ORE.

COUNTY SURVEYORS FILE DATA
DO NOT REMOVE FROM OFFICE