FILED
RECEIVED

SEP 16 1969

COUNTY SURVEYOR
DOUGLAS COUNTY, ORE.

COUNTY SURVEYORS FILE DATA

SURVEY FOR DEED DESCRIPTION
IN SEC. 2, T.28S., R.6 W.W.M.
SURVED FOR STEVENSON REALTY
by BRUCE ROGERS
SEPT. 16, 1969
1" = 60'

REGISTERED
OREGON
LAND SURVEYOR

Bruce R. Rogers

JULY 10, 1964
BRUCE R. ROGERS
660

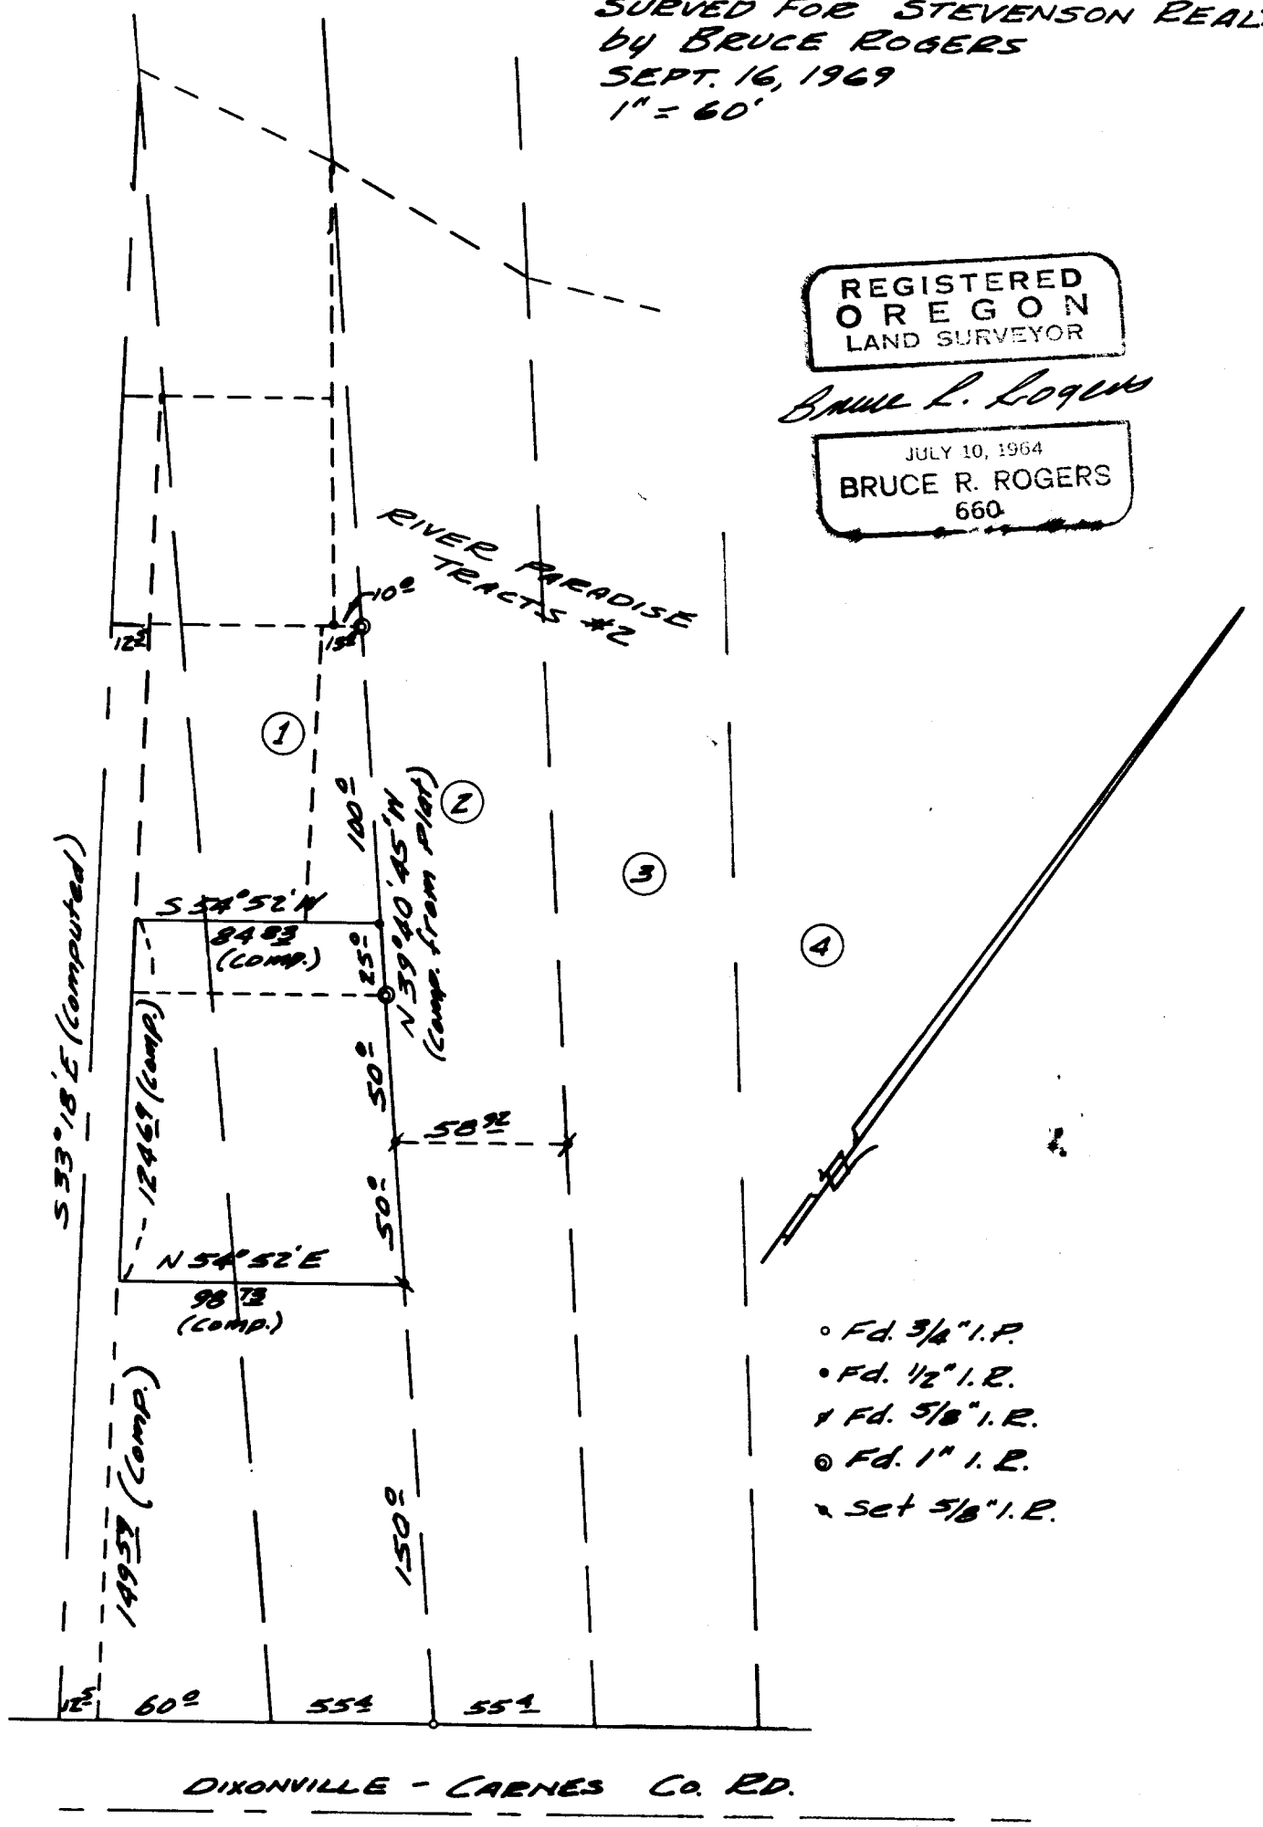

∘ Fd. 3/4" I.P.
• Fd. 1/2" I.R.
Fd. 5/8" I.R.
⊙ Fd. 1" I.R.
Set 5/8" I.R.

File No. 55/125-1