FILED & RECEIVED
OCT 17 1969
COUNTY SURVEYOR
DOUGLAS COUNTY, ORE.

[redacted]

SURVEY FOR DEED DESCRIPTION
IN SEC. 24, T. 26 S., R. 7 W. W.M.
SURVEYED FOR P. WASHBURN
by BRUCE ROGERS
OCT. 1969
1" = 200'

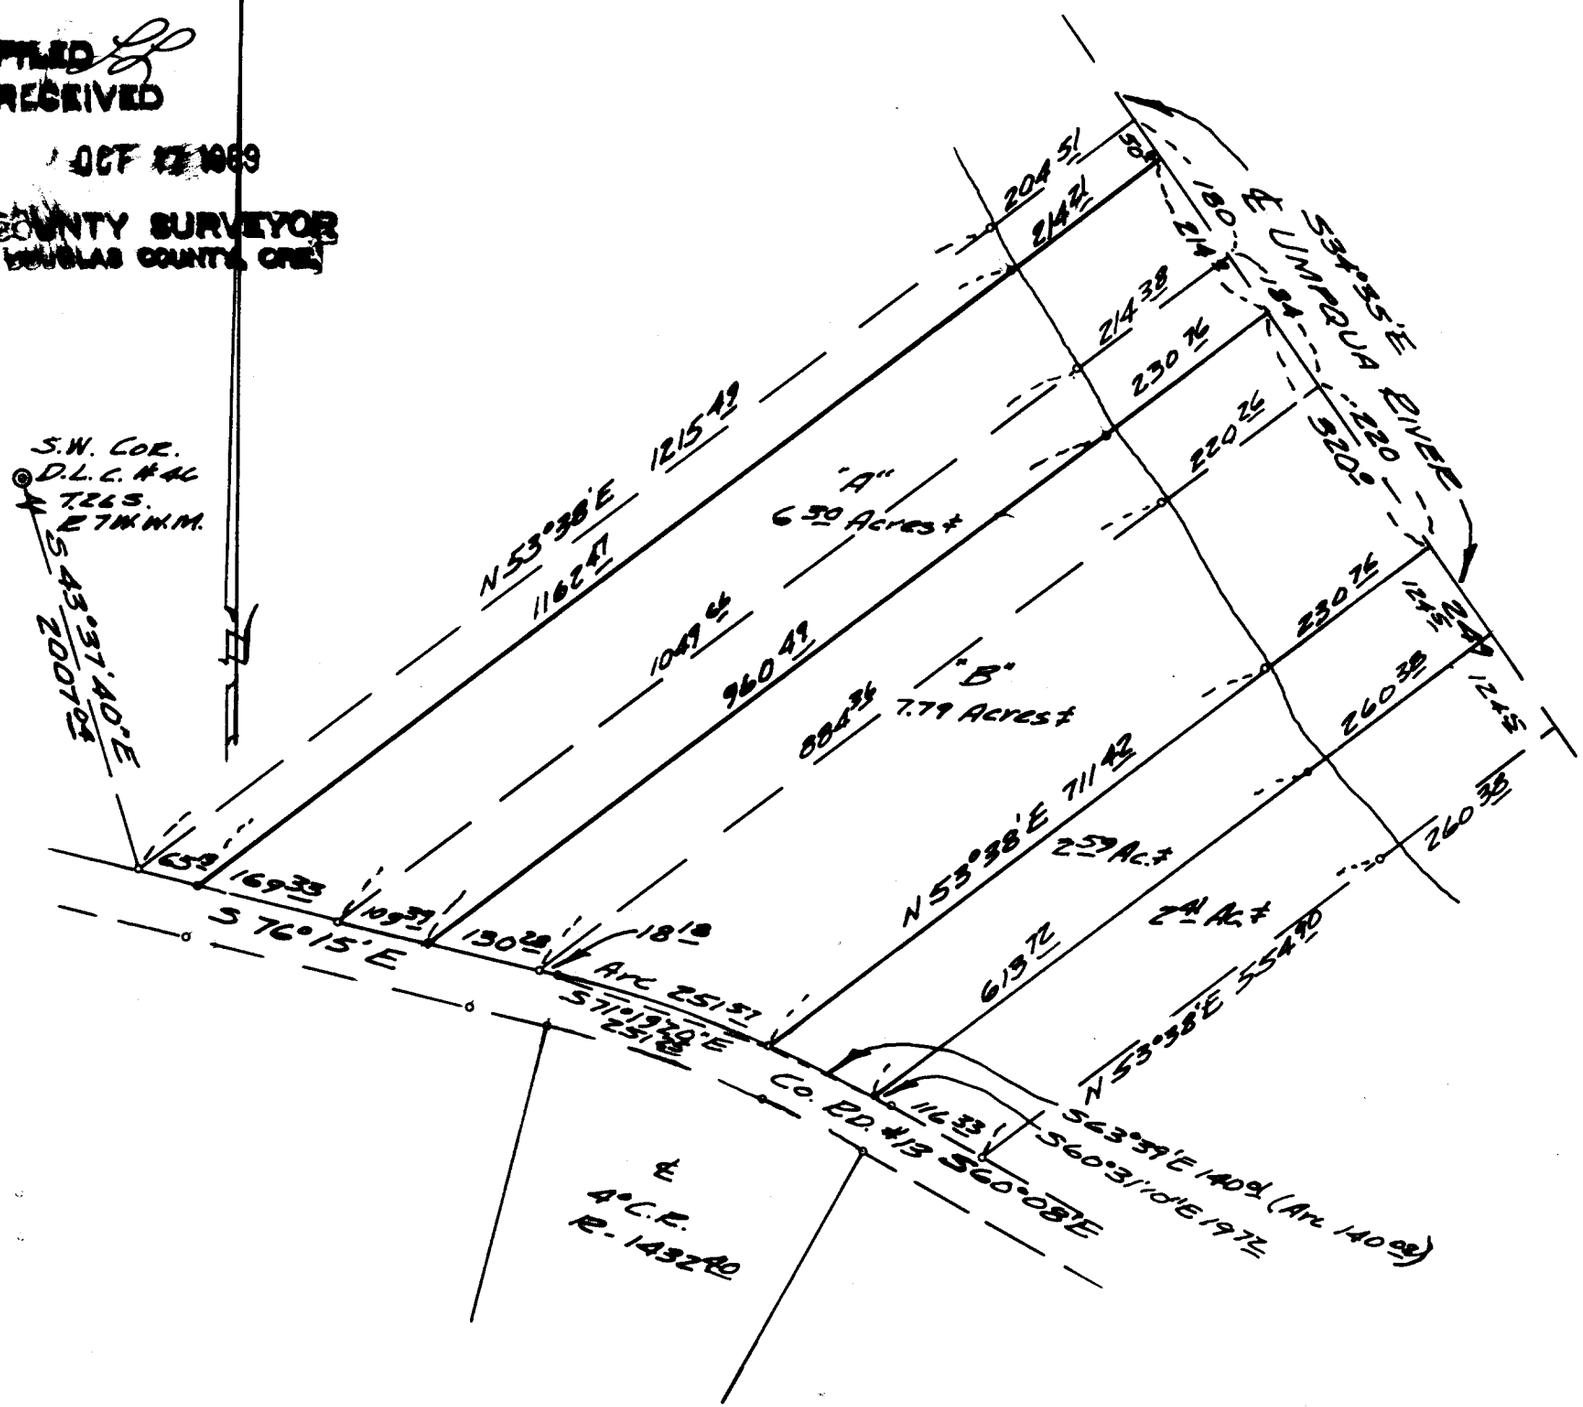

REGISTERED
OREGON
LAND SURVEYOR
Bruce R. Rogers
JULY 10, 1964
BRUCE R. ROGERS
660

○ – Fd. 5/8" I.R. (See C.S. M38-11)
• – set 5/8" I.R.

C. S. File No. 55/125-3