COUNTY SURVEYORS FILE BOOK
DO NOT REMOVE FROM OFFICE

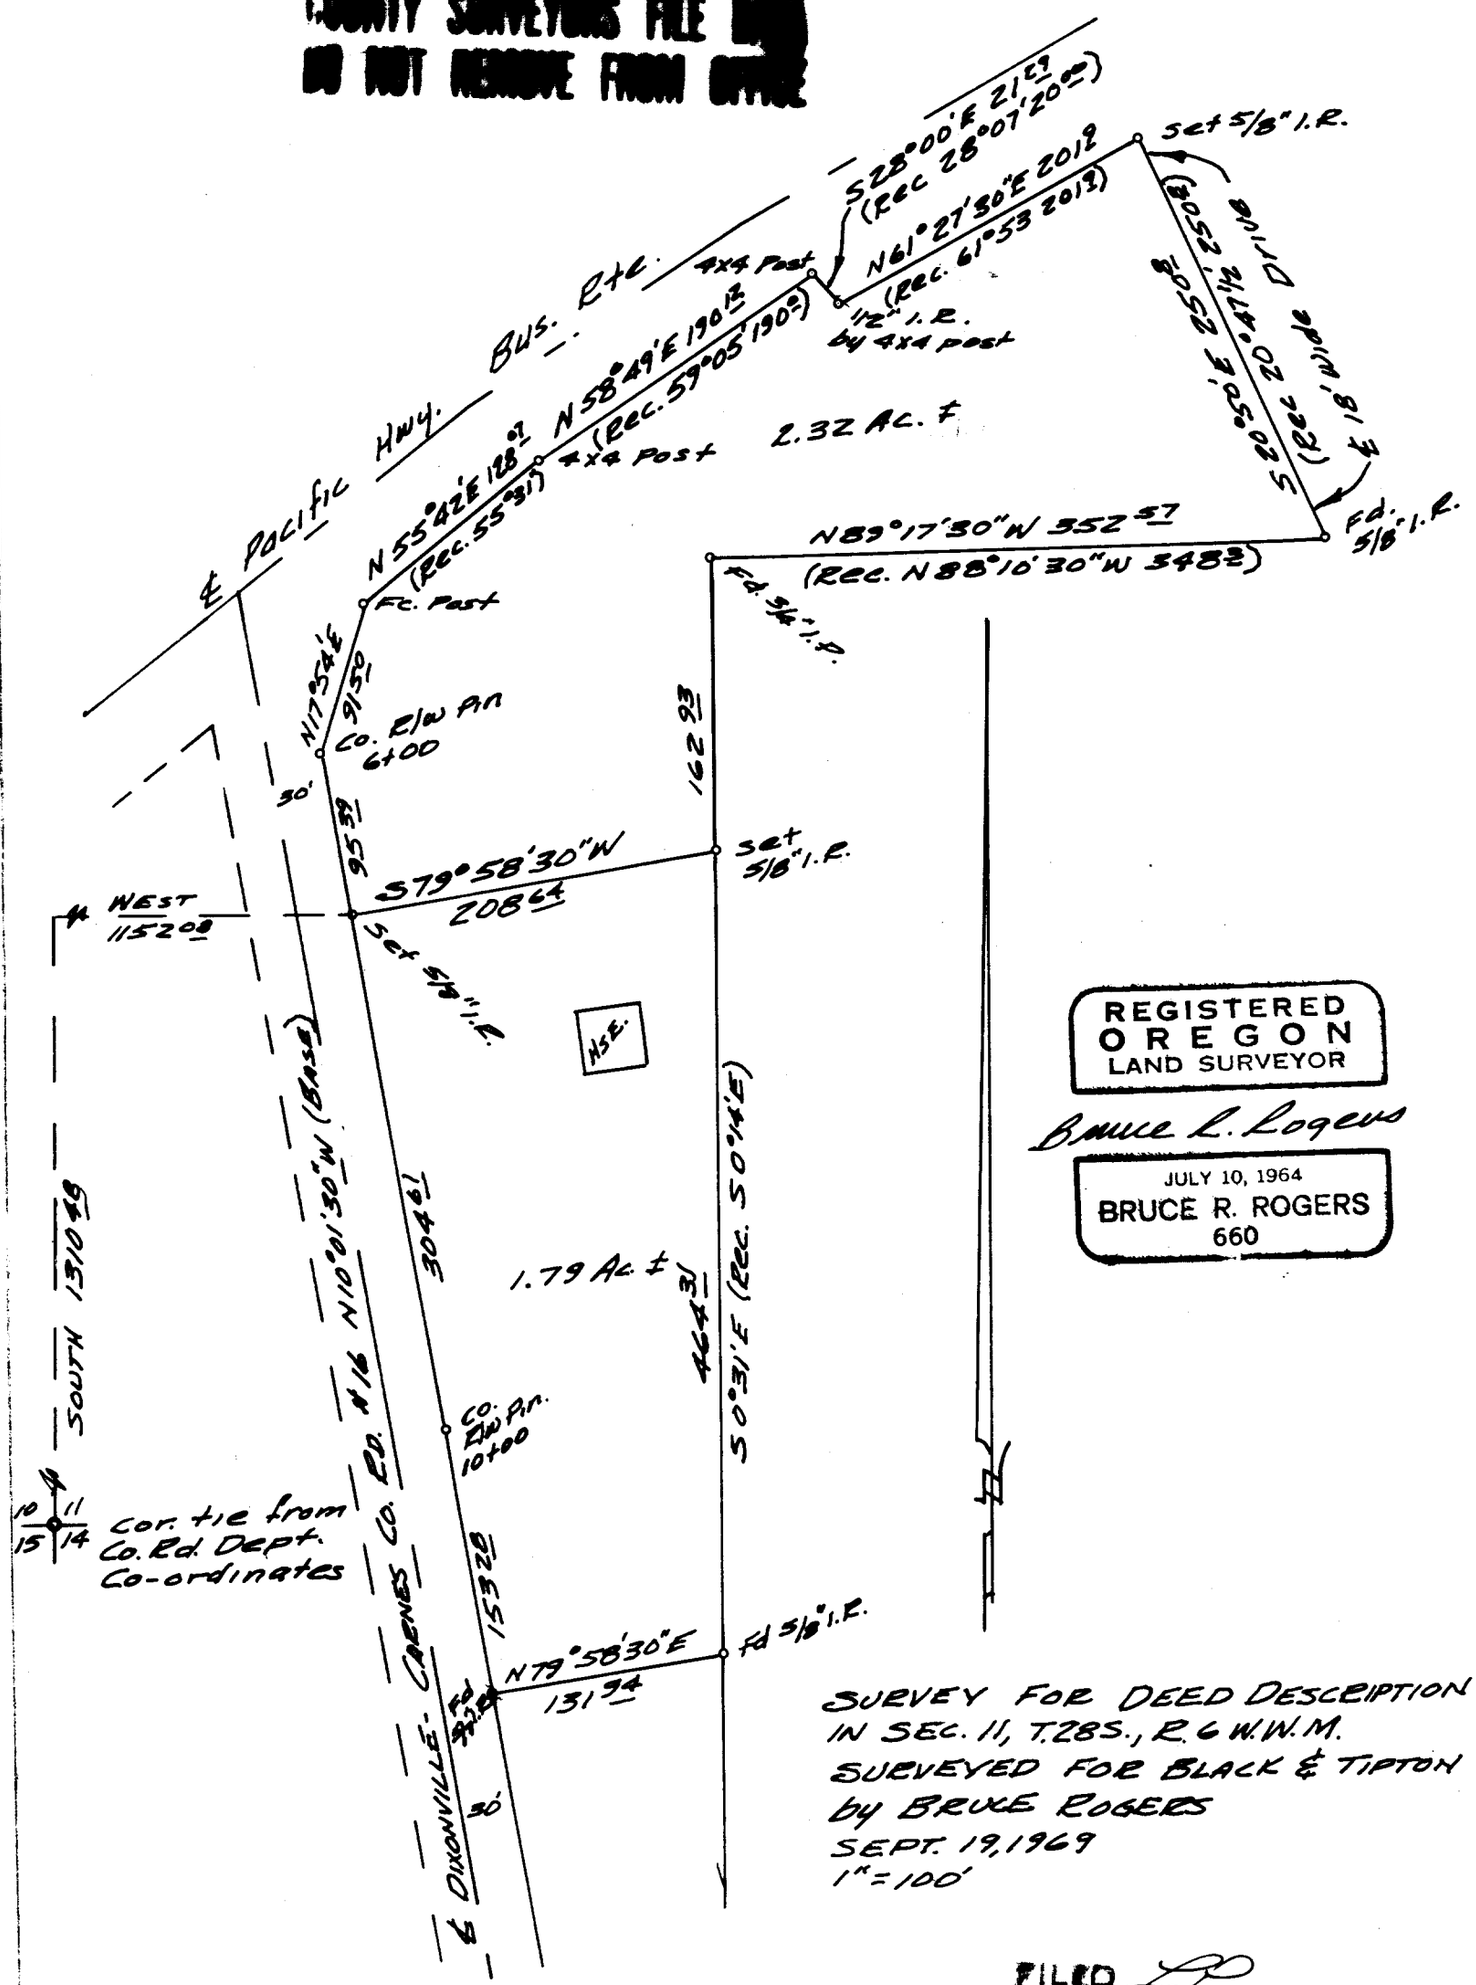

REGISTERED
OREGON
LAND SURVEYOR

Bruce R. Rogers

JULY 10, 1964
BRUCE R. ROGERS
660

SURVEY FOR DEED DESCRIPTION
IN SEC. 11, T.28S., R.6 W.W.M.
SURVEYED FOR BLACK & TIPTON
by BRUCE ROGERS
SEPT. 19, 1969
1" = 100'

FILED
RECEIVED
SEP 19 1969
COUNTY SURVEYOR
DOUGLAS COUNTY, ORE.
P C. S. File No. 55/125