FILED
RECEIVED
OCT 31 1969
COUNTY SURVEYOR
DOUGLAS COUNTY, ORE.

COUNTY SURVEYORS FILE DATA
[redacted]

PARTIAL SUBDIVISION OF THE S.W 1/4 of N.W 1/4
SECTION 23, T. 27S., R 3 W.W.M.
SURVEYED FOR UNITED FARM AGENCY
by BRUCE ROGERS
OCT. 1969
1" = 200'

REGISTERED
OREGON
LAND SURVEYOR
Bruce L. Rogers
JULY 10, 1964
BRUCE R. ROGERS
660

• - Fd. 5/8" I.R.
○ - Set 5/8" I.R.

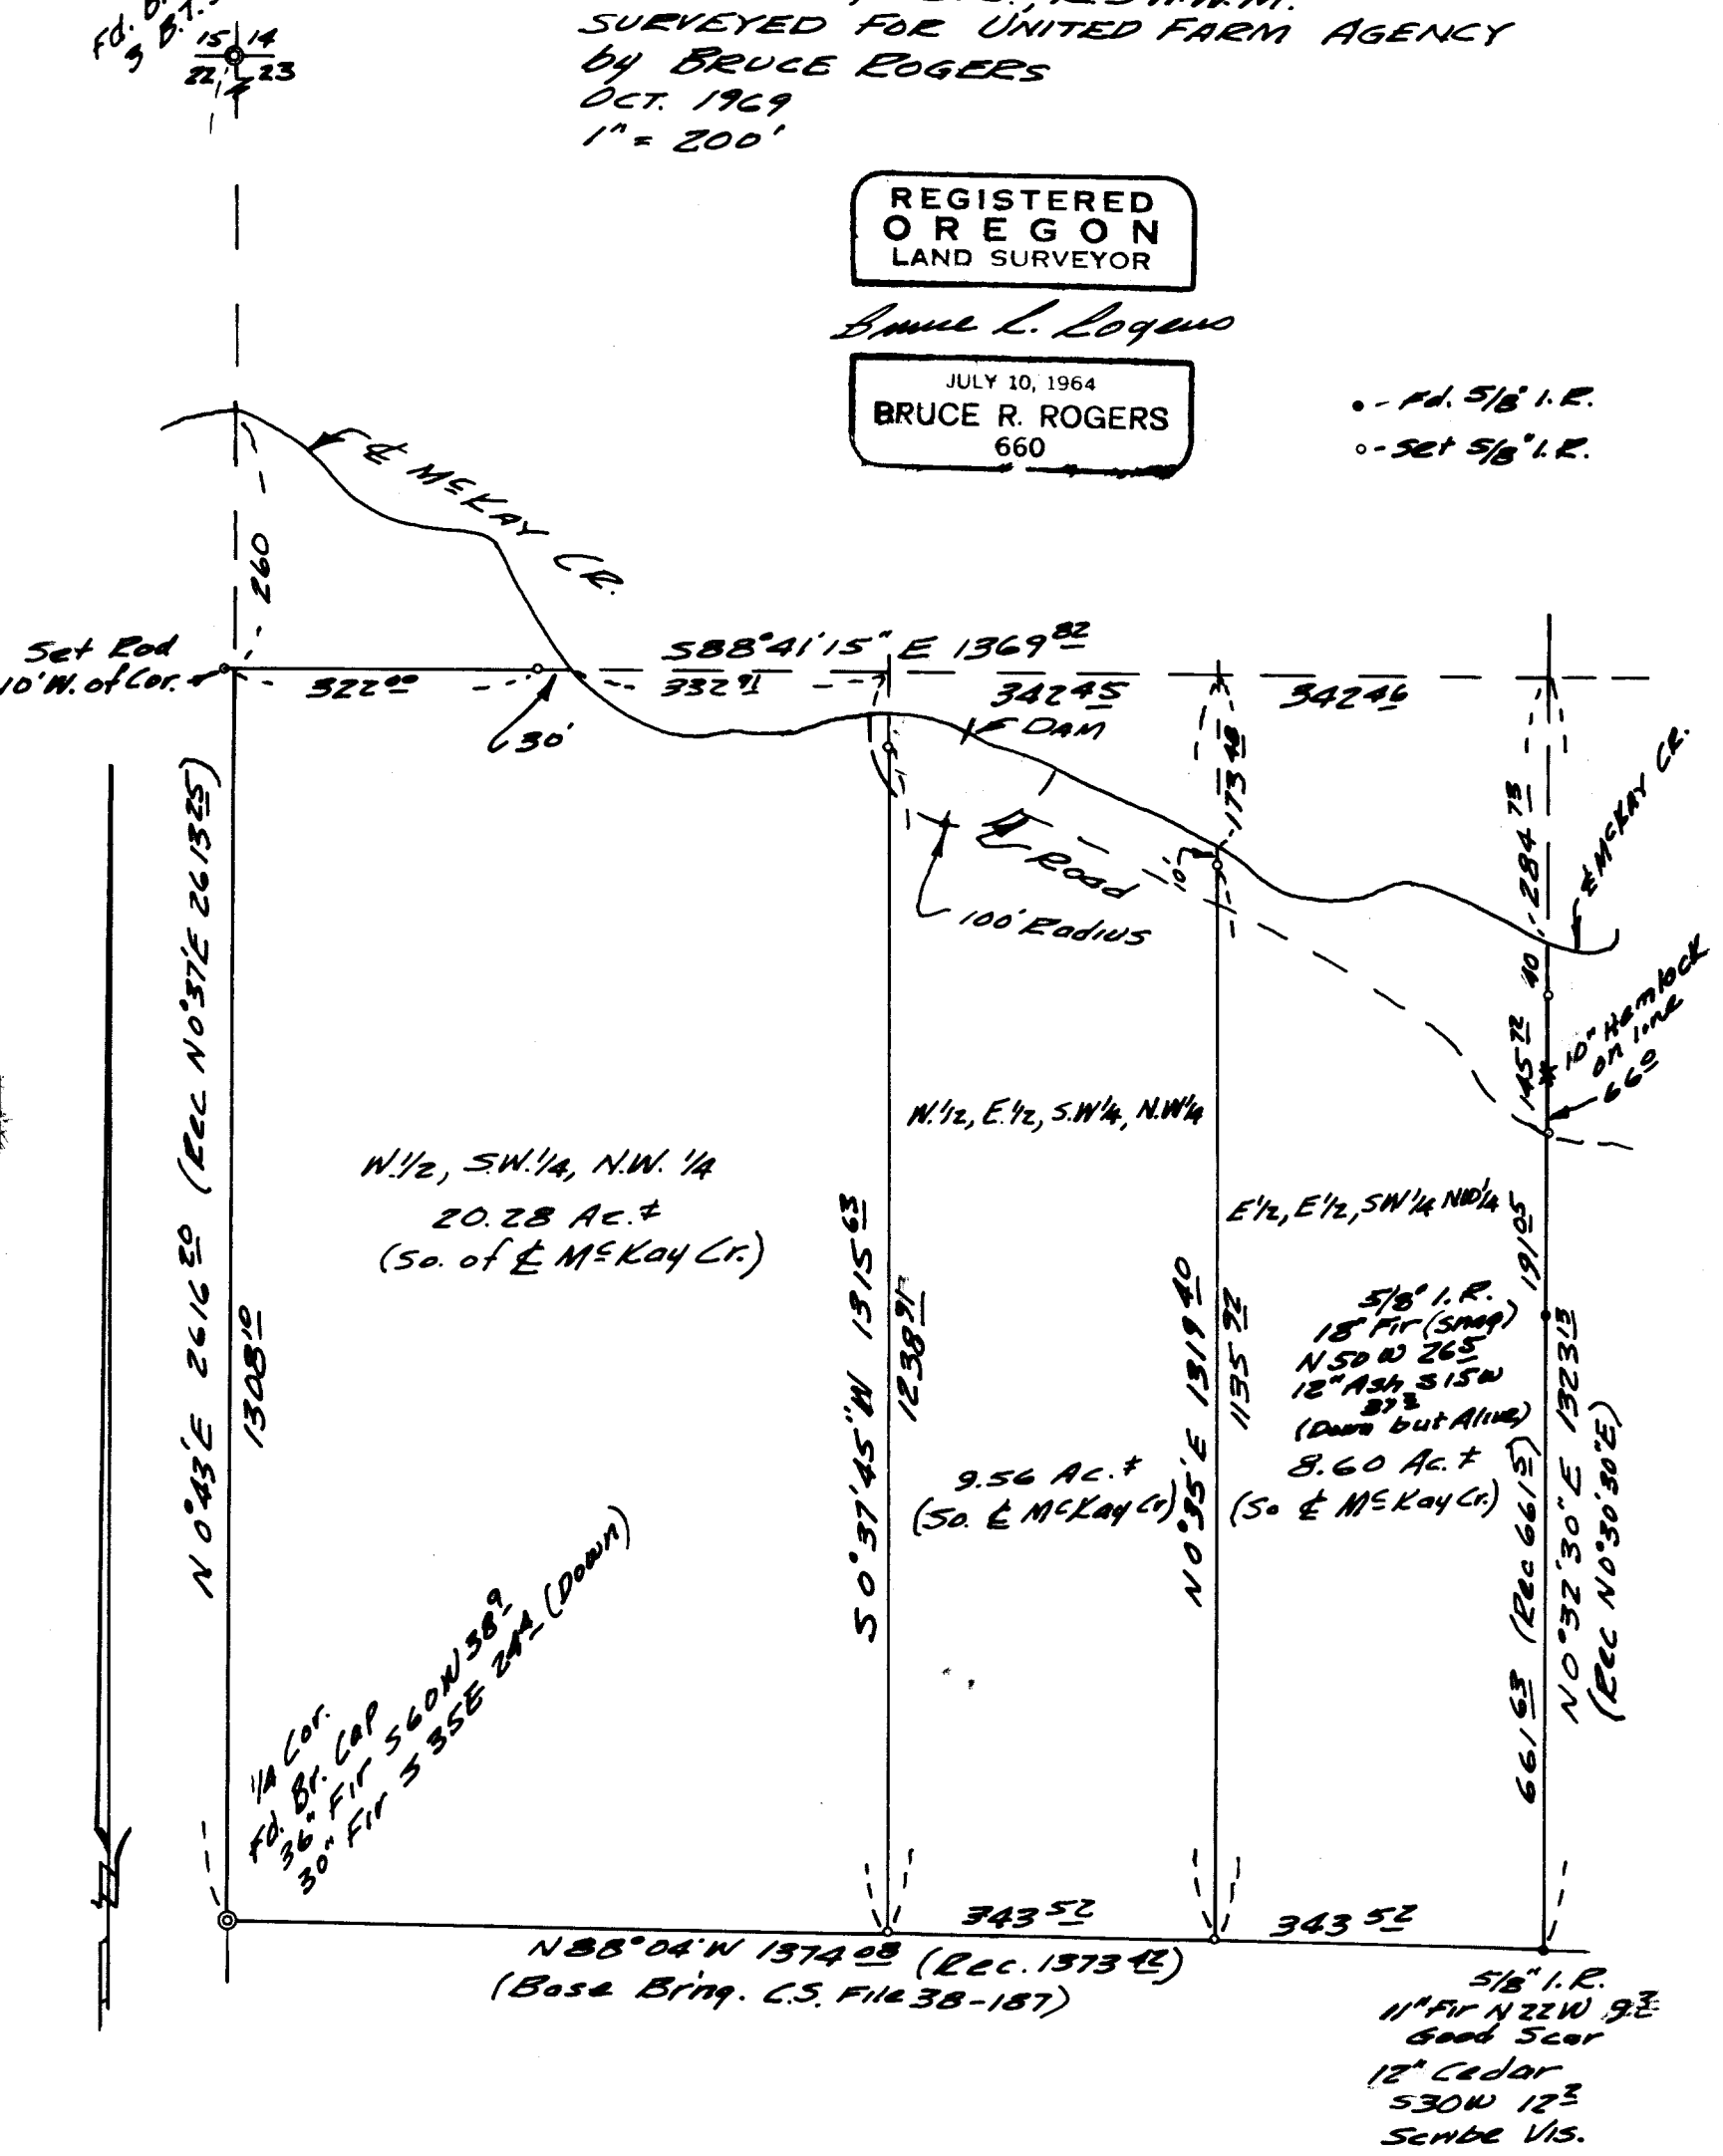

File No. 55/130-1