SURVEY FOR DEED DESCRIPTION
IN SEC. 36 T25S R7W W.M. DOUGLAS CO. ORE.
SURVEYED FOR COLES VALLEY CEMETERY ASSO.
Nov. 1969 By BRUCE R. ROGERS

COUNTY SURVEYORS FILE DATA
DO NOT REMOVE FROM OFFICE

REGISTERED
OREGON
LAND SURVEYOR

Bruce R. Rogers

JULY 10, 1964
BRUCE R. ROGERS
660

FILED LL
RECEIVED
NOV 13 1969
COUNTY SURVEYOR
DOUGLAS COUNTY, ORE.

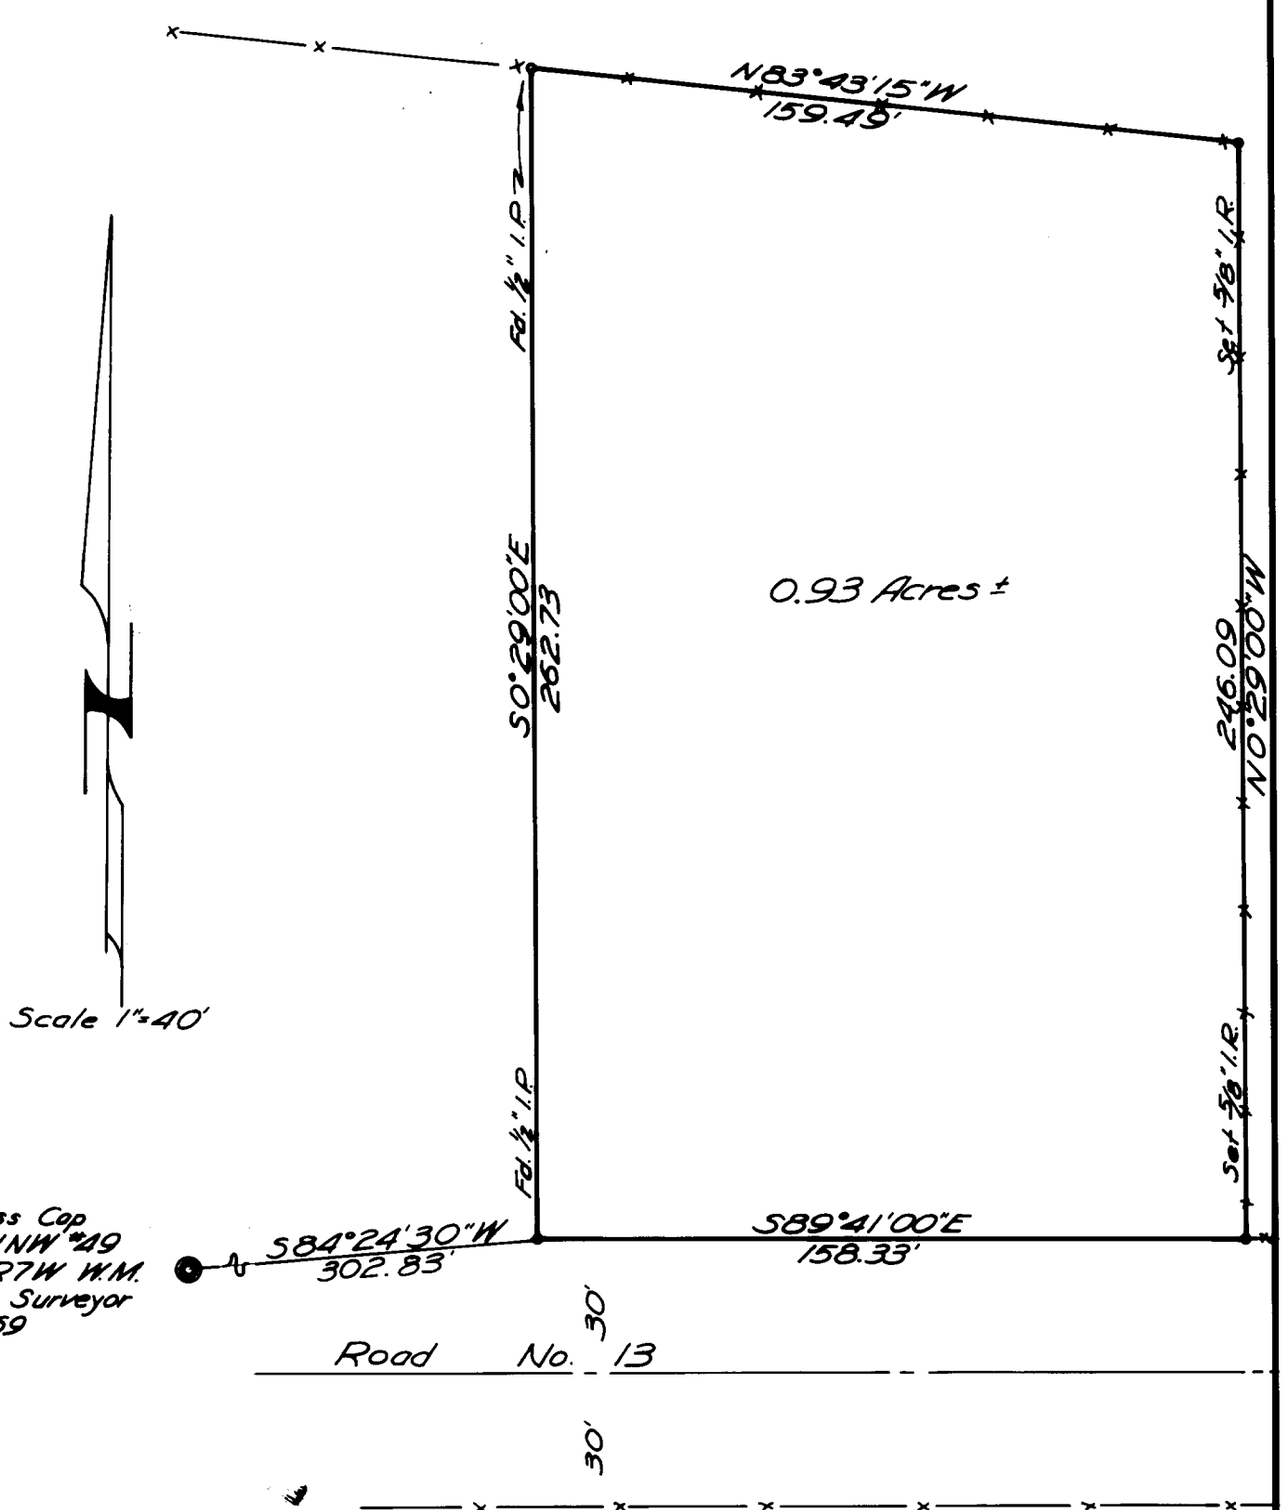

P U.S. File No. 55/130-2