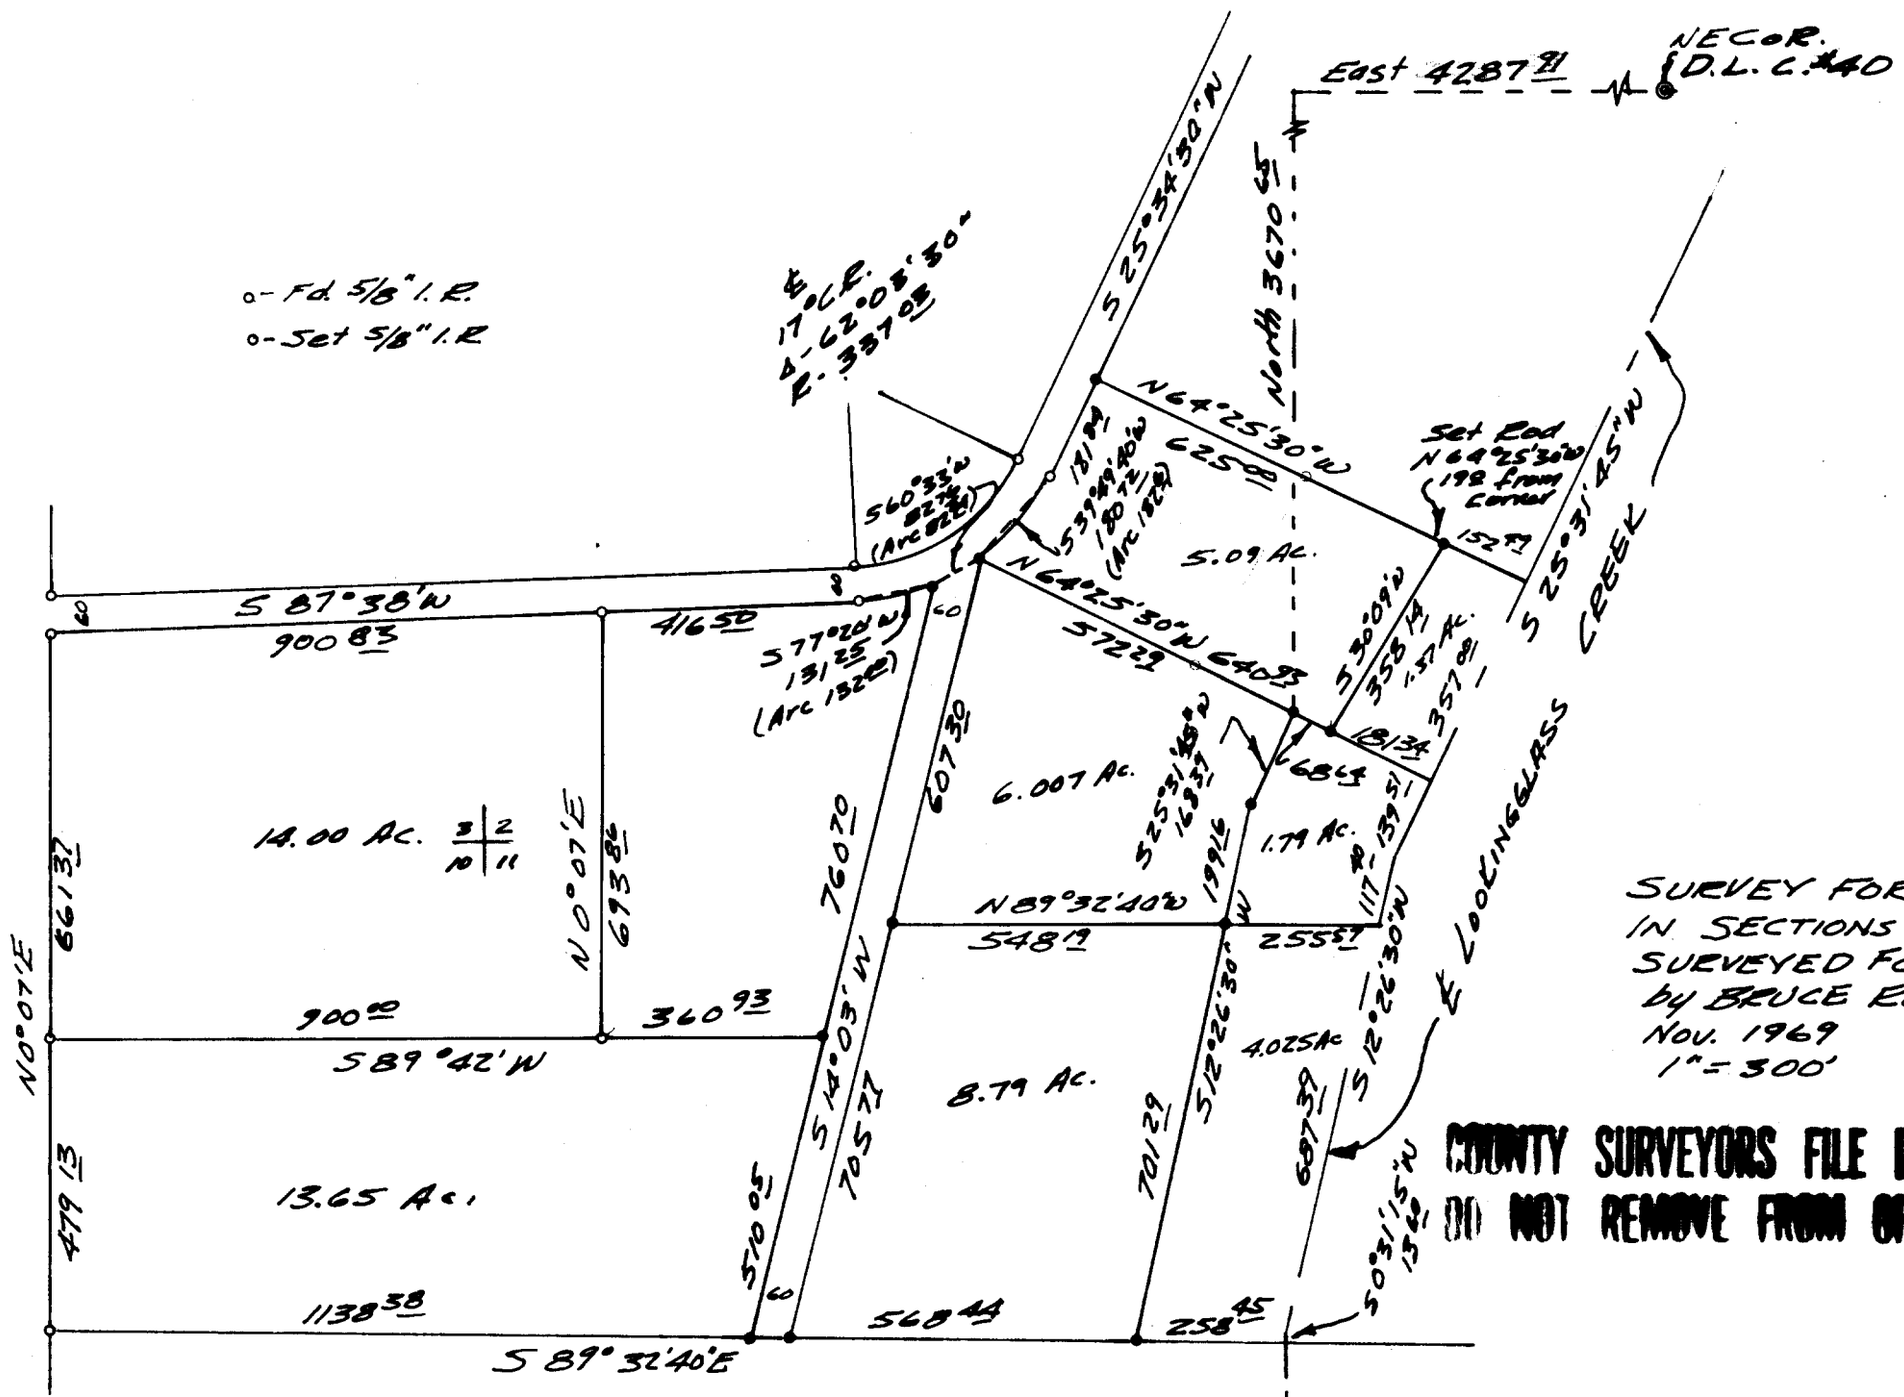

FILED
RECEIVED
NOV 21 1969
COUNTY SURVEYOR
DOUGLAS COUNTY, ORE.

SURVEY FOR DEED DESCRIPTION
IN SECTIONS 2, 3, 10 & 11, T.28S., R.7W.W.M.
SURVEYED FOR NORTHWEST PROP.
by BRUCE ROGERS
NOV. 1969
1" = 300'

COUNTY SURVEYORS FILE DATA
DO NOT REMOVE FROM OFFICE

REGISTERED
OREGON
LAND SURVEYOR
Bruce R. Rogers
JULY 10, 1964
BRUCE R. ROGERS
660

C. S. File No. 55/130-3