FILED
RECEIVED

DEC 9 1969

COUNTY SURVEYOR
DOUGLAS COUNTY, ORE.

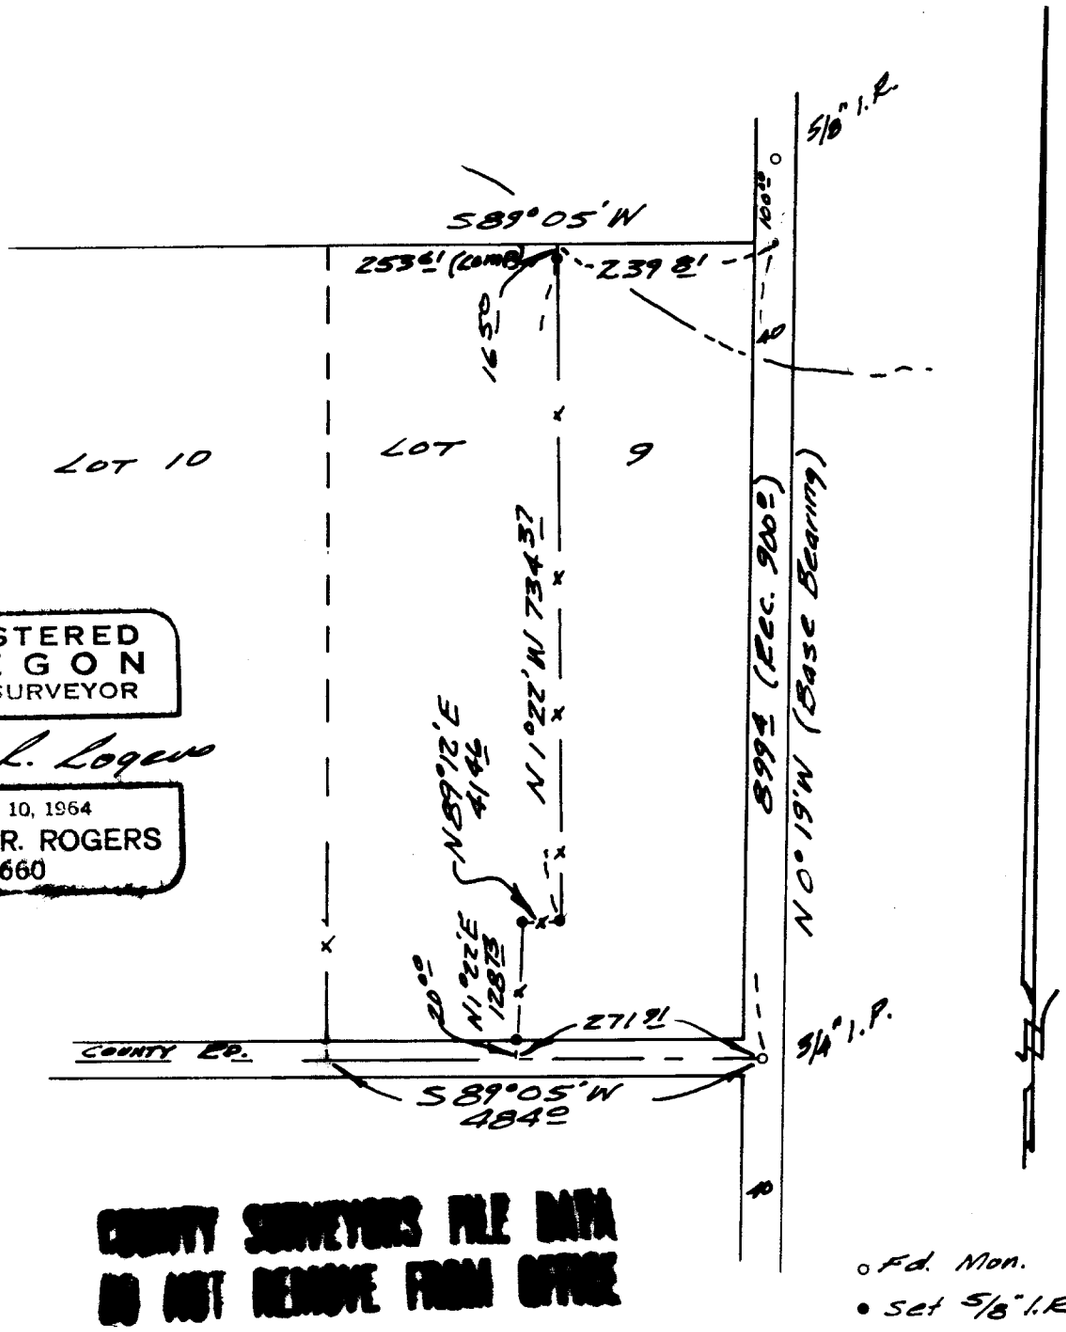

REGISTERED
OREGON
LAND SURVEYOR

Bruce L. Rogers

JULY 10, 1964
BRUCE R. ROGERS
660

COUNTY SURVEYORS FILE DATA
DO NOT REMOVE FROM OFFICE

○ Fd. Mon.
● Set 5/8" I. Rod

SURVEY FOR DEED DESCRIPTION
IN LOT 9 BLK. 6, PLAT I
SUTHERLIN LAND & WATER CO.
SURVEYED FOR UNITED FARM AGENCY
BY BRUCE ROGERS
NOV., 1969
1" = 200'

T25-5 Sec 13 & 24 ... No. 55/130-4