[redacted]

FILED
RECEIVED
DEC 10 1969
COUNTY SURVEYOR
DOUGLAS COUNTY, ORE.

T. 25-5-22B

SURVEY TO SET PROPERTY CORNERS
LOT 13, BLK 3, PLAT N
SUTHERLIN LAND & WATER CO.
SURVEYED FOR E. WALESON
by BRUCE ROGERS
DEC., 1969
1" = 300'

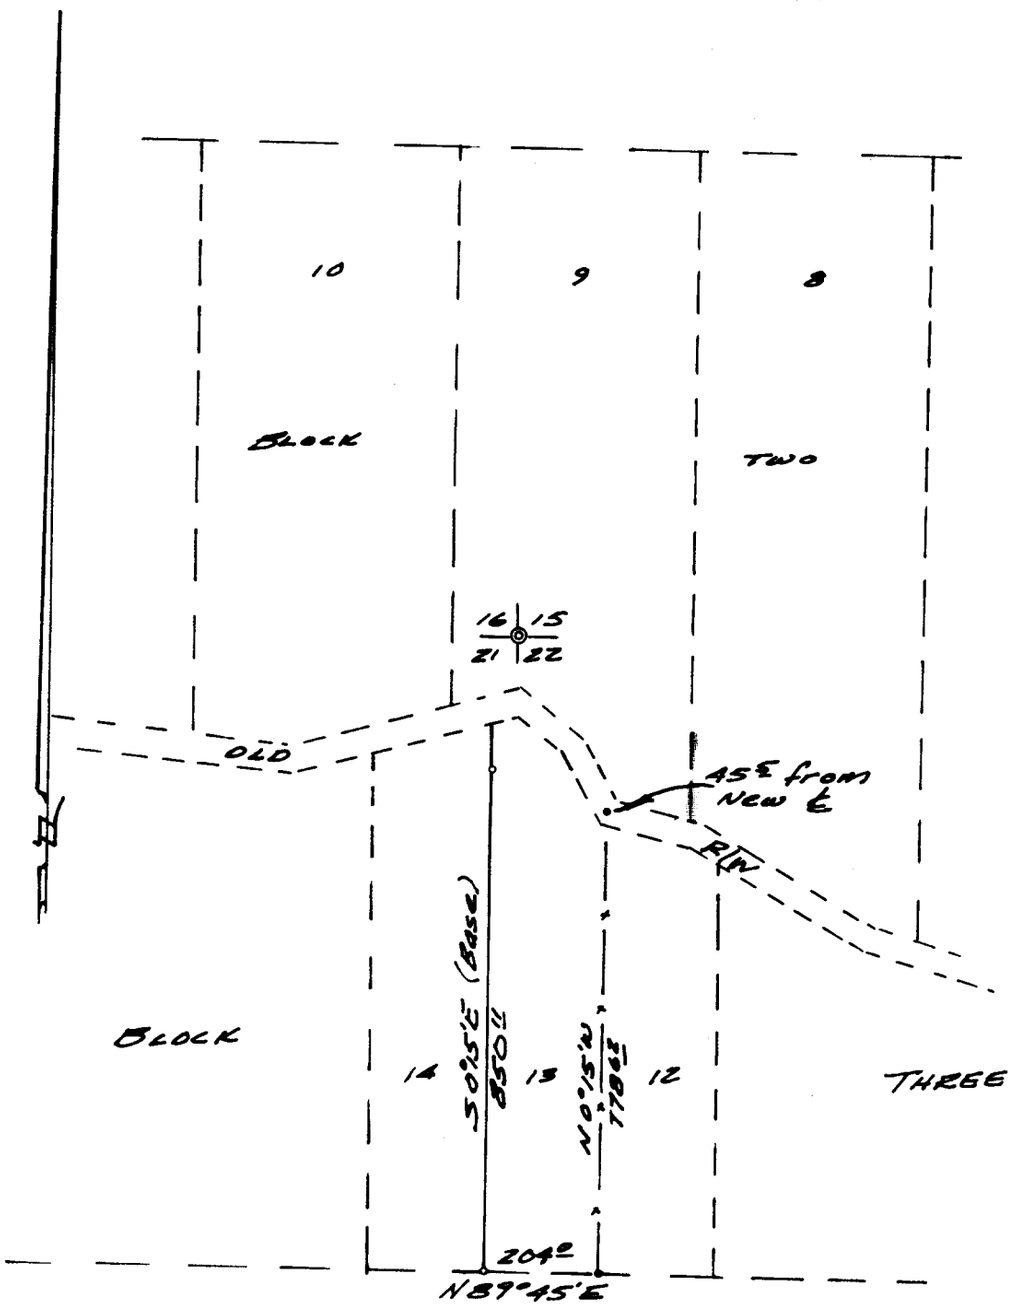

REGISTERED
OREGON
LAND SURVEYOR
Bruce L. Rogers
JULY 10, 1954
BRUCE R. ROGERS
660

o - Fd 5/8" I. R. (C.S. M36-63)
• - Set 5/8" I. R.

C. S. File No. 55/132-2