SURVEY TO SET PROPERTY CORNERS
IN THE S.E 1/4, N.W. 1/4 SEC. 32, T.30S., R.5 W.W.M.
SURVEYED FOR SERAFIN REALTY
by BRUCE ROGERS
JAN. 16, 1970
1" = 100'

COUNTY SURVEYORS FILE DATA
DO NOT REMOVE FROM OFFICE

FILED
RECEIVED
JAN 20 1970
COUNTY SURVEYOR
DOUGLAS COUNTY, ORE.

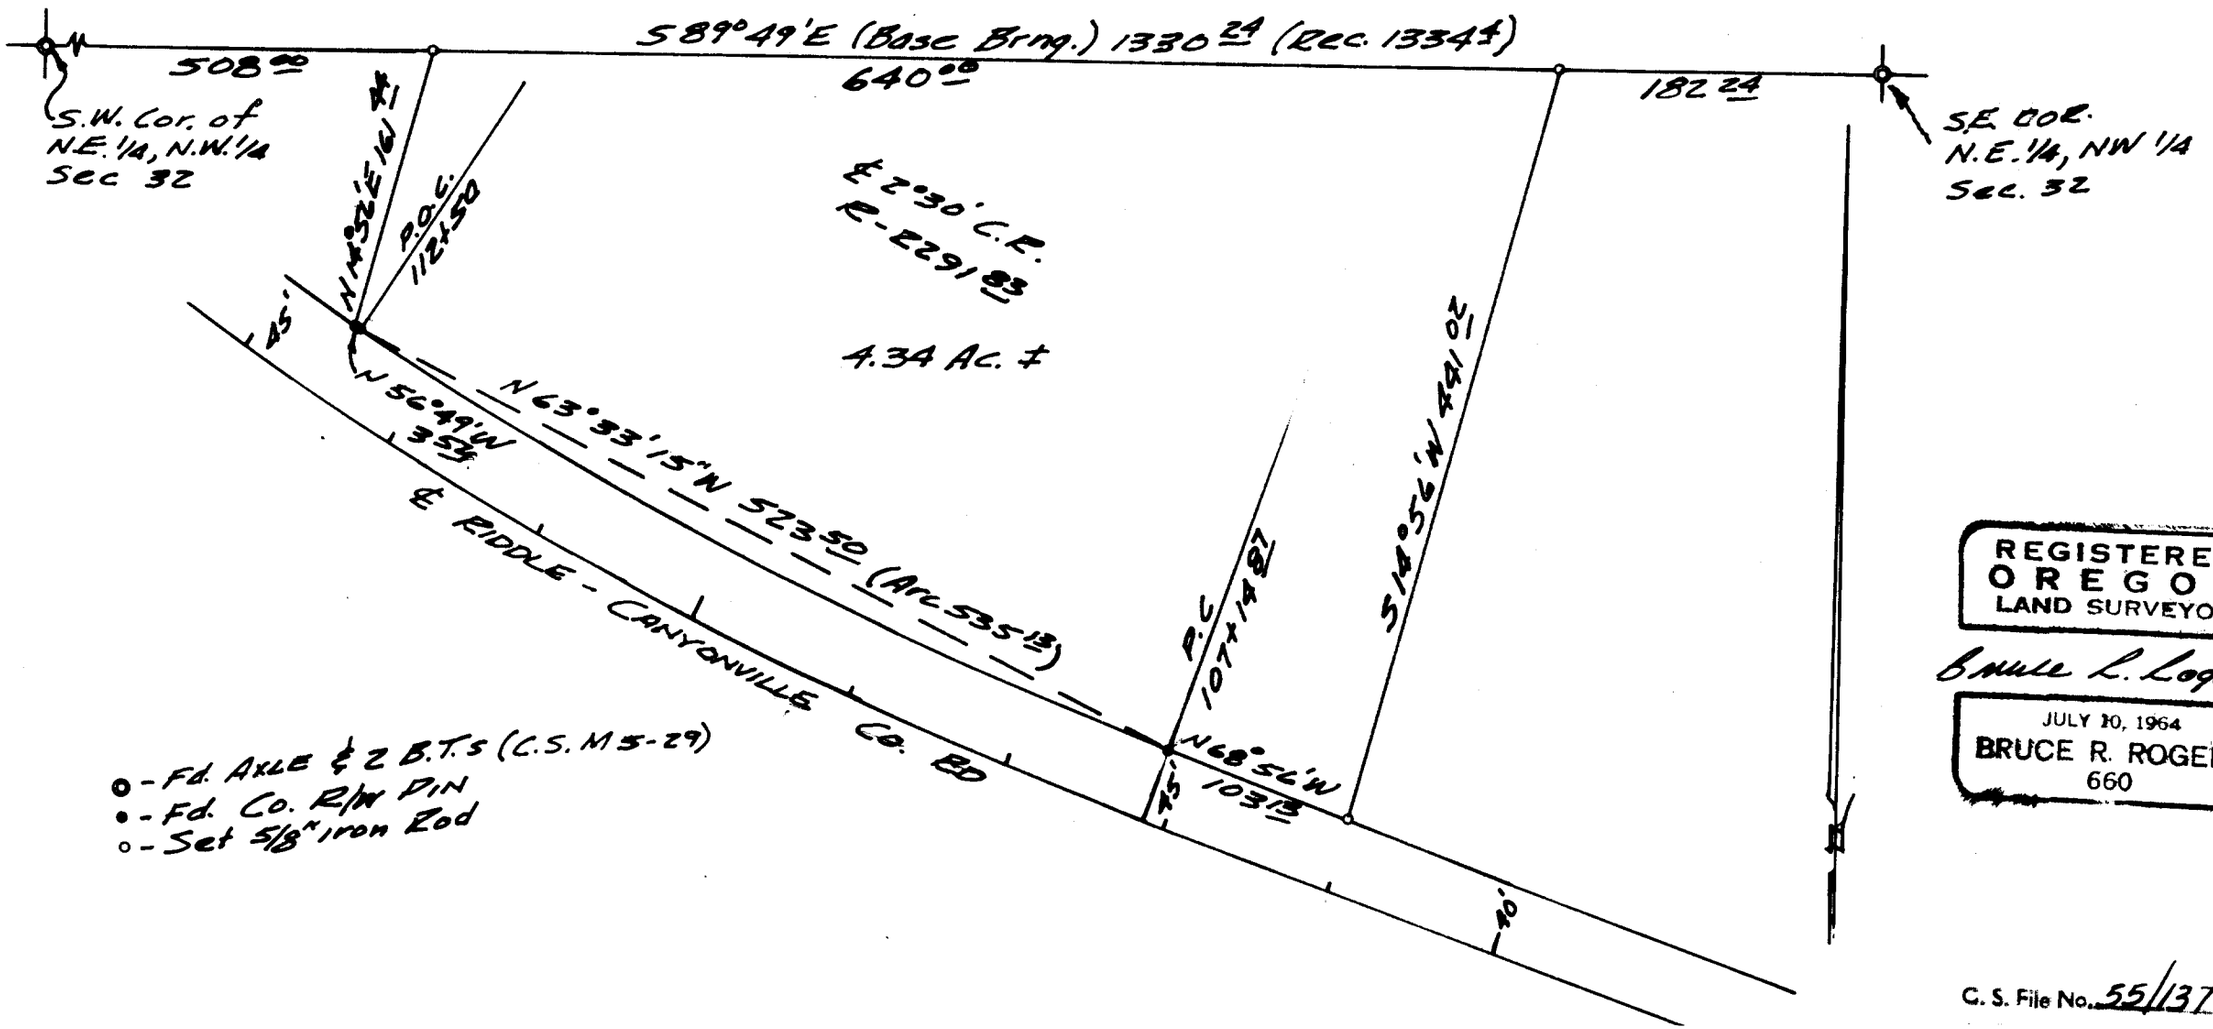


REGISTERED
OREGON
LAND SURVEYOR
Bruce R. Rogers
JULY 10, 1964
BRUCE R. ROGERS
660

C. S. File No. 55/137-1