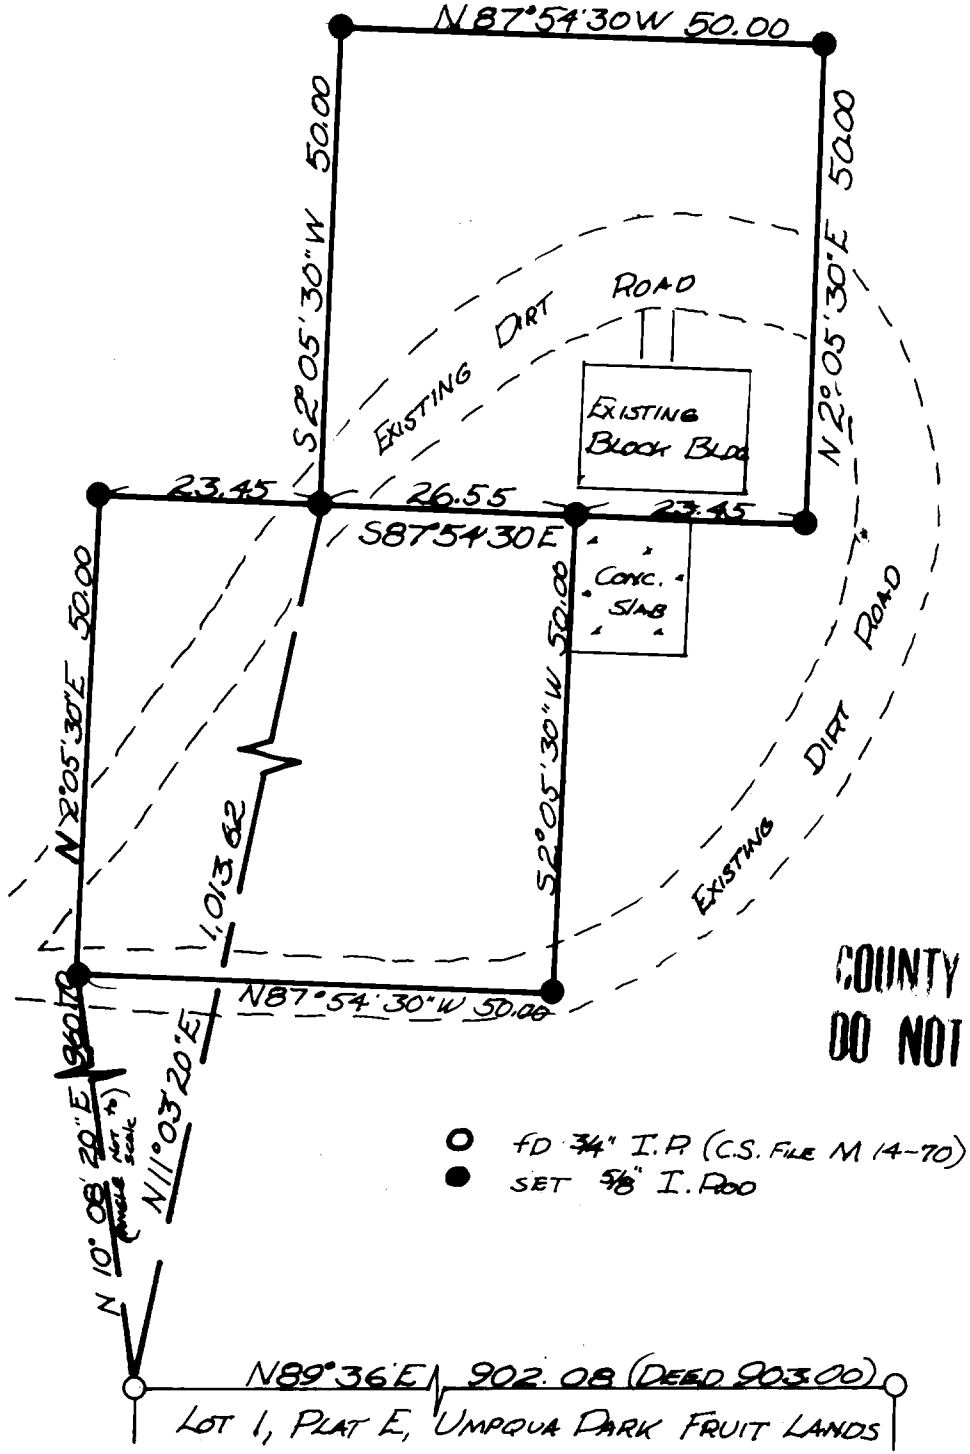


BEARINGS BASED ON
CS FILE M 14-70

FILED
RECEIVED

JUL 29 1970

COUNTY SURVEYOR
DOUGLAS COUNTY, ORE.

FIELD SURVEY & PLAT FOR

# SELMAR A. HUTCHINS

ROSEBURG, OREGON

A PARCEL LOCATED IN SW 1/4 SEC 24
T27S R6W W.M. DOUGLAS COUNTY ORE.

SCALE 1"=20'

DONALD A. BENTZ ~ REG'D LAND SURVEYOR

JUNE 1970

COUNTY SURVEYORS FILE DATA
DO NOT REMOVE FROM OFFICE

○ FD 3/4" I.P. (C.S. FILE M 14-70)
● SET 5/8" I.P.

REGISTERED
OREGON
LAND SURVEYOR

JULY 12, 1968
DONALD A. BENTZ
839

55/139-2