

RESTORED CORNER FOR STATE OF OREGON--DEPARTMENT OF FORESTRY

One quarter corner common to Sections 24 and 25, T22S, R12W, W.M., Douglas County, Oregon.

ORIGINAL

Hemlock post (missing) from which a:

40" Fir bears N 88 3/4° E 65 lks.; now 75" stump, scribes 1/4 S exposed.

36" Cedar bears S 16 3/4° E 40 lks.; now 42", face grown over.

RESTORED

Set 1 1/2" x 36" galvanized iron pipe with 3" bronze cap marked "OREGON STATE BOARD OF FORESTRY 1/4 S24 S25 1970 RS359". 34 inches in ground, in mound of rock, and from which a:

42" Cedar bears N 61° E 75.1 ft. to face; scribed 1/4 S24 BT.


42" Cedar (orig.) bears S 16 3/4° E 24.0 ft. to face; scribed RS359.

Set 4" x 4" x 72" white painted Cedar post 1.2 ft. NE of corner pipe. Oregon State Forestry Department metal location poster on 42" Cedar BT N 61° E 75.1 ft.

Dated May 21, 1970

Restored by C. Wayne Cook under my direction.
C. Wayne Cook, Transitman

Present and witnessed by David R. Brown
Steven F. Howard
Donald E. Wright

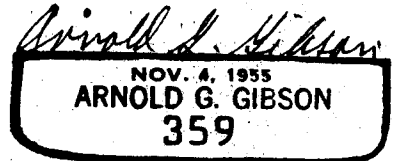

661

FILED
RECEIVED

JUN 17 1970

COUNTY SURVEYOR
DOUGLAS COUNTY, ORE.

C. S. File No. 55/184-2