

RESTORED CORNER FOR STATE OF OREGON--DEPARTMENT OF FORESTRY

Section corner common to Sections 15, 16, 21 and 22, T22S, R11W, W.M., Douglas County, Oregon.

ORIGINAL

12" x 10" x 8" Stone (in place, badly decomposed) from which a:

- 4" Fir bears N25°E 26 lks.; now 17" stp., chopped into, no scribes visible.
- 6" Fir bears S60°E 4 lks.; now 21" x 12 ft. stub, with 12" x 6" x 10 ft. section split out from base of chopping to top of stub.
- 8" Fir bears S69°W 15 lks.; now 21", face grown over.
- 7" Fir bears N25°W 11 lks.; now 19" x 11 ft. stump, scribe B visible.

RESTORED

Set 1½" x 36" galvanized iron pipe with 3" bronze cap marked "OREGON STATE BOARD OF FORESTRY T22S R11W S15 S16 S21 S22 1970 RS 359", 24 inches in ground with original stone alongside, in mound of rock, and from which a:


- 17" Fir (Original) bears S69°W 9.9 ft. scribed RS 359.
- 10" Fir bears S3°E 48.8 ft. to face; scribed T22S R11W S15 BT.
- 24" Fir bears S62°E 43.3 ft. to face; scribed T22S R11W S22 BT.

Set 4" x 4" x 72" white painted Cedar post 2.8 ft. N28°E of corner pipe. Oregon State Forestry Department metal location poster on 17" Fir (orig.) S69°W 9.9 ft.

Dated July 15, 1970

Restored by Lloyd D. Smith  
Lloyd D. Smith, Transitman

under my direction.

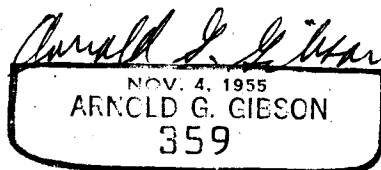

Present and witnessed by David R. Brown

FILED  
RECEIVED

AUG 20 1970

COUNTY SURVEYOR  
DOUGLAS COUNTY, ORE.

988

55/154-7