U S PUBLIC LAND CORNERS

S 2 Twp. 26 S Range 9 W W M.

WEYERHAEUSER TIMBER CO.

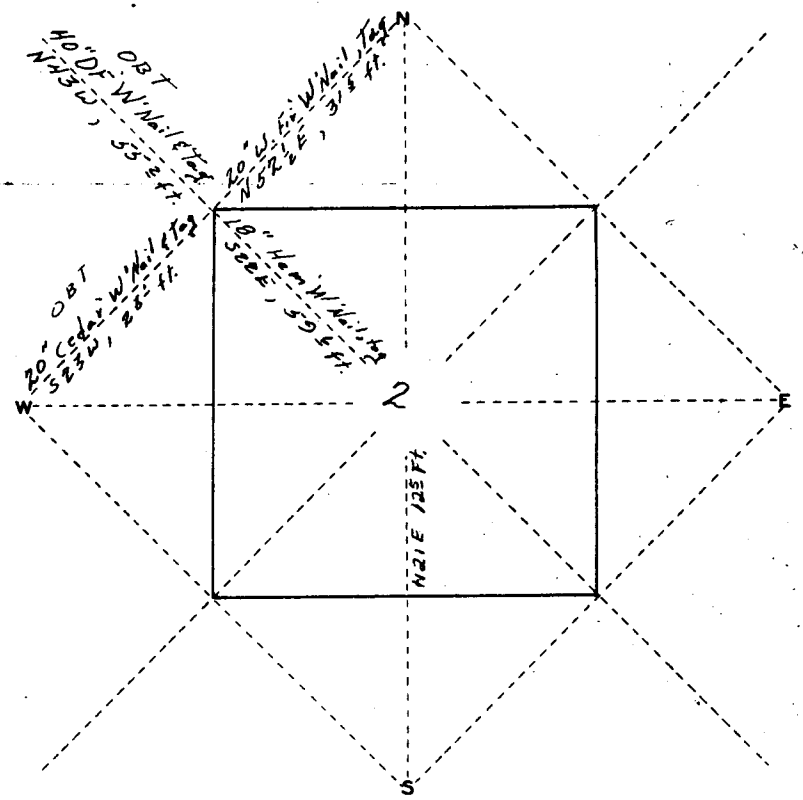

COR.	IDENTIFIED BY B.T.'S.	POST	STONE	MKS.	WITNESSED BY PIPE	TAG	DATE	BY WHOM
NE								
N¼								
NW	2					4	6/63	Reppeto, Stevens, Queen, Kuhkle & Smith
W¼								
SW	✓					✓		FOUND. F.O.W.
S¼								
SE								
E¼								

FIELD RECORD FOR OFFICE DATA

WITNESSED BY

FORM 402 WTCO.

FILED
RECEIVED

JUN 17 1970

COUNTY SURVEYOR
DOUGLAS COUNTY, ORE.

C. S. File No. 55/155B