U.S. PUBLIC LAND CORNERS

Sec. 13 Twp. 26 S Range 9 W. W.M.

WEYERHAEUSER TIMBER CO.

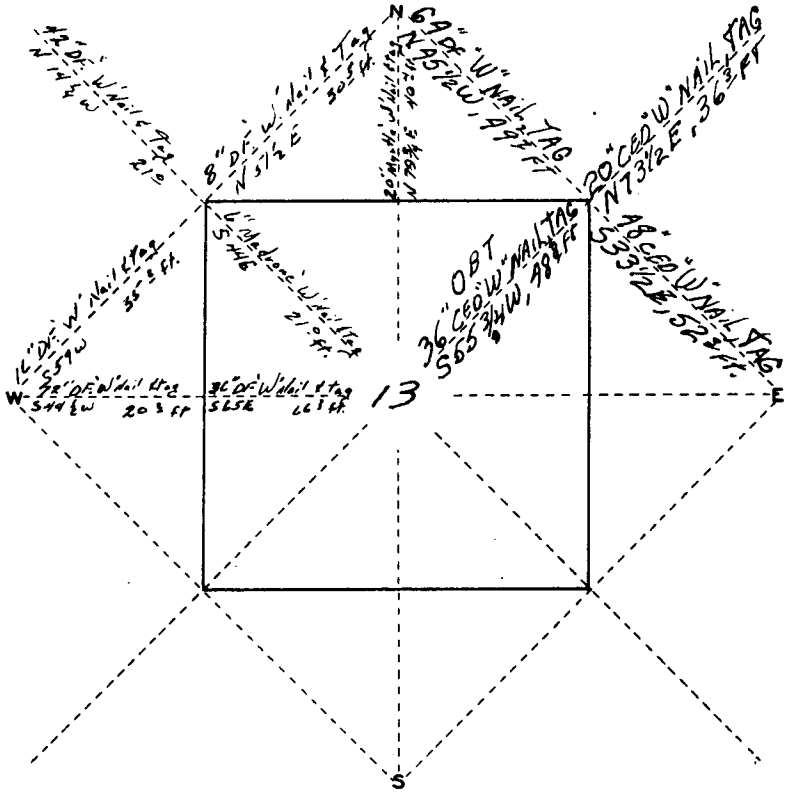

COR.	IDENTIFIED BY B.T.'S.	POST	STONE	MKS.	WITNESSED BY PIPE	TAG	DATE	BY WHOM
NE	3			✓		5	10/61	STEVENS-KAUFFMAN HUMPHREYS-KUNKLE
N 1/4	1				✓	2	7/63	Stevens Kunkle Smith
NW	2			✓	✓	4	7/63	Stevens Kunkle Smith
W 1/4	1				✓	2	7/63	Stevens Kunkle Smith
SW								
S 1/4								
SE								
E 1/4								

FIELD RECORD FOR OFFICE DATA

WITNESSED BY

FORM 402 WTCO.

FILED
RECEIVED

JUN 17 1970

COUNTY SURVEYOR
DOUGLAS COUNTY, ORE.

C. S. File No. 55/155 B-9