U S PUBLIC LAND CORNERS

S 23 Twp. 26 S Range 9 W M.

WEYERHAEUSER TIMBER CO.

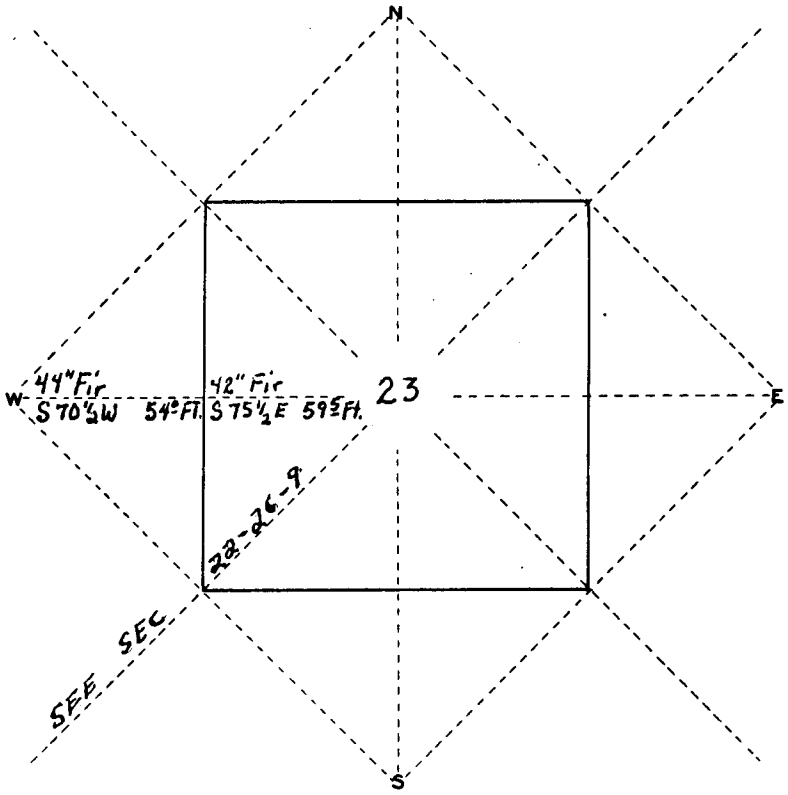

COR.	IDENTIFIED BY B.T.'S.	POST	STONE	MKS.	WITNESSED BY PIPE	TAG	DATE	BY WHOM
NE								
N¼								
NW								
W¼	1						8/67	Williams, Thiemens, Iles
SW	4					✓	9/68	WILLIAMS, LESTER
S¼								
SE								
E¼								

FIELD RECORD FOR OFFICE DATA

WITNESSED BY

FORM 402 WTCO.

FILED
RECEIVED
JUN 17 1970
COUNTY SURVEYOR
DOUGLAS COUNTY, ORE.

C. S. File No. 55/155 B-10.