COUNTY SURVEYORS FILE DATA
DO NOT REMOVE FROM OFFICE

REGISTERED
OREGON
LAND SURVEYOR

Bruce R. Rogers

JULY 10, 1964
BRUCE R. ROGERS
660

SURVEY FOR DEED DESCRIPTION
IN D.L.C. #38, D.L.C. #46 & LOT 7, SEC 24, T.26S., R.7W.
FOR IVAN ROGERS
by BRUCE ROGERS
AUG., 1970
1" = 200'

FILED
RECEIVED
SEP 4 1970
COUNTY SURVEYOR
DOUGLAS COUNTY, ORE.

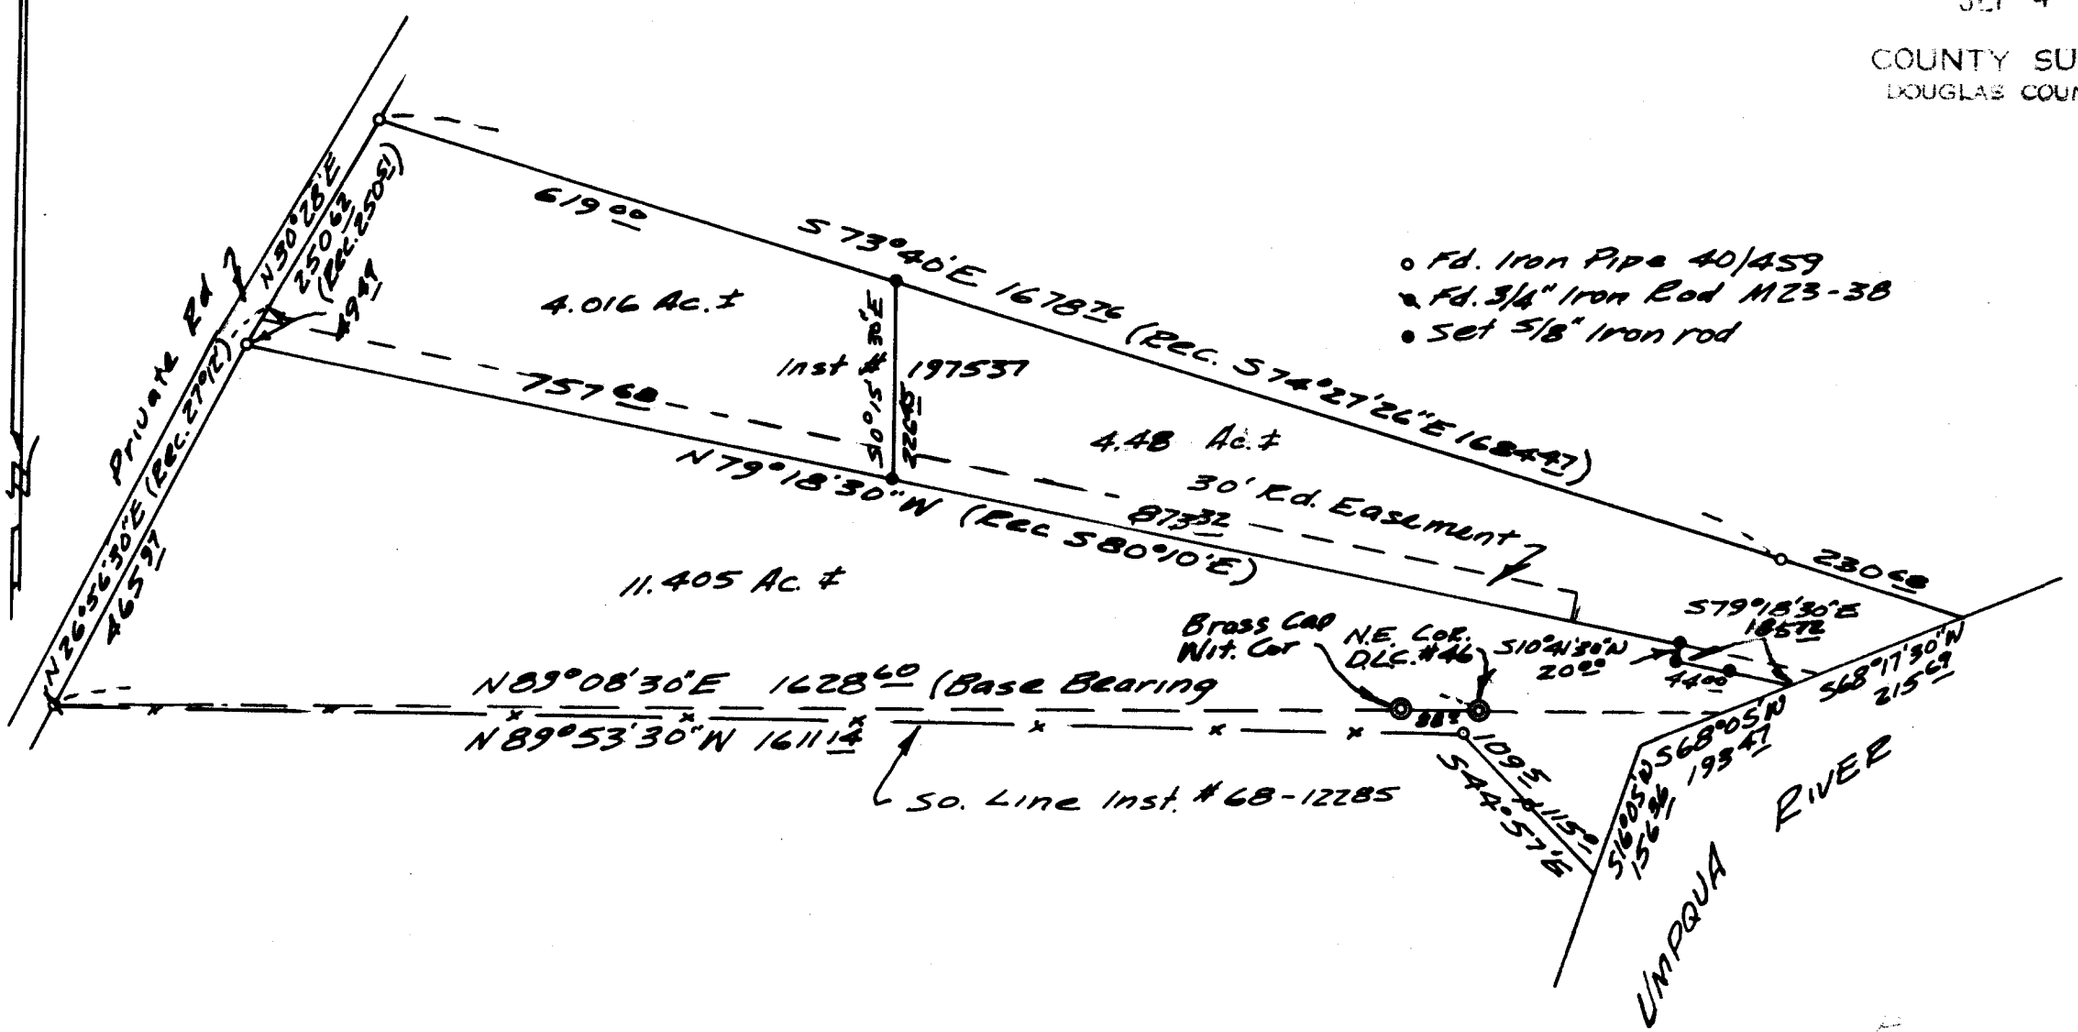

55/162-1