SURVEYED FOR DEED DESCRIPTION
SITUATED IN SEC. 9, T. 21S., R. 11 W.W.M.
FOR DAVID & DORIS MAYS DEC. 1970
BY BAUGHMAN & ACKARET INC.
SCALE 1" = 100'

COUNTY SURVEYORS FILE DATA
DO NOT REMOVE FROM OFFICE

BASE OF BEARINGS SOLAR OBSERVATION

• SET P.K. NAIL
○ SET 5/8" IRON ROD

REGISTERED
OREGON
LAND SURVEYOR
Glenn S. Baughman
JULY 14, 1961
GLENN S. BAUGHMAN
536

FILED
RECEIVED
JAN 19
COUNTY SURVEYOR
DOUGLAS COUNTY, ORE.

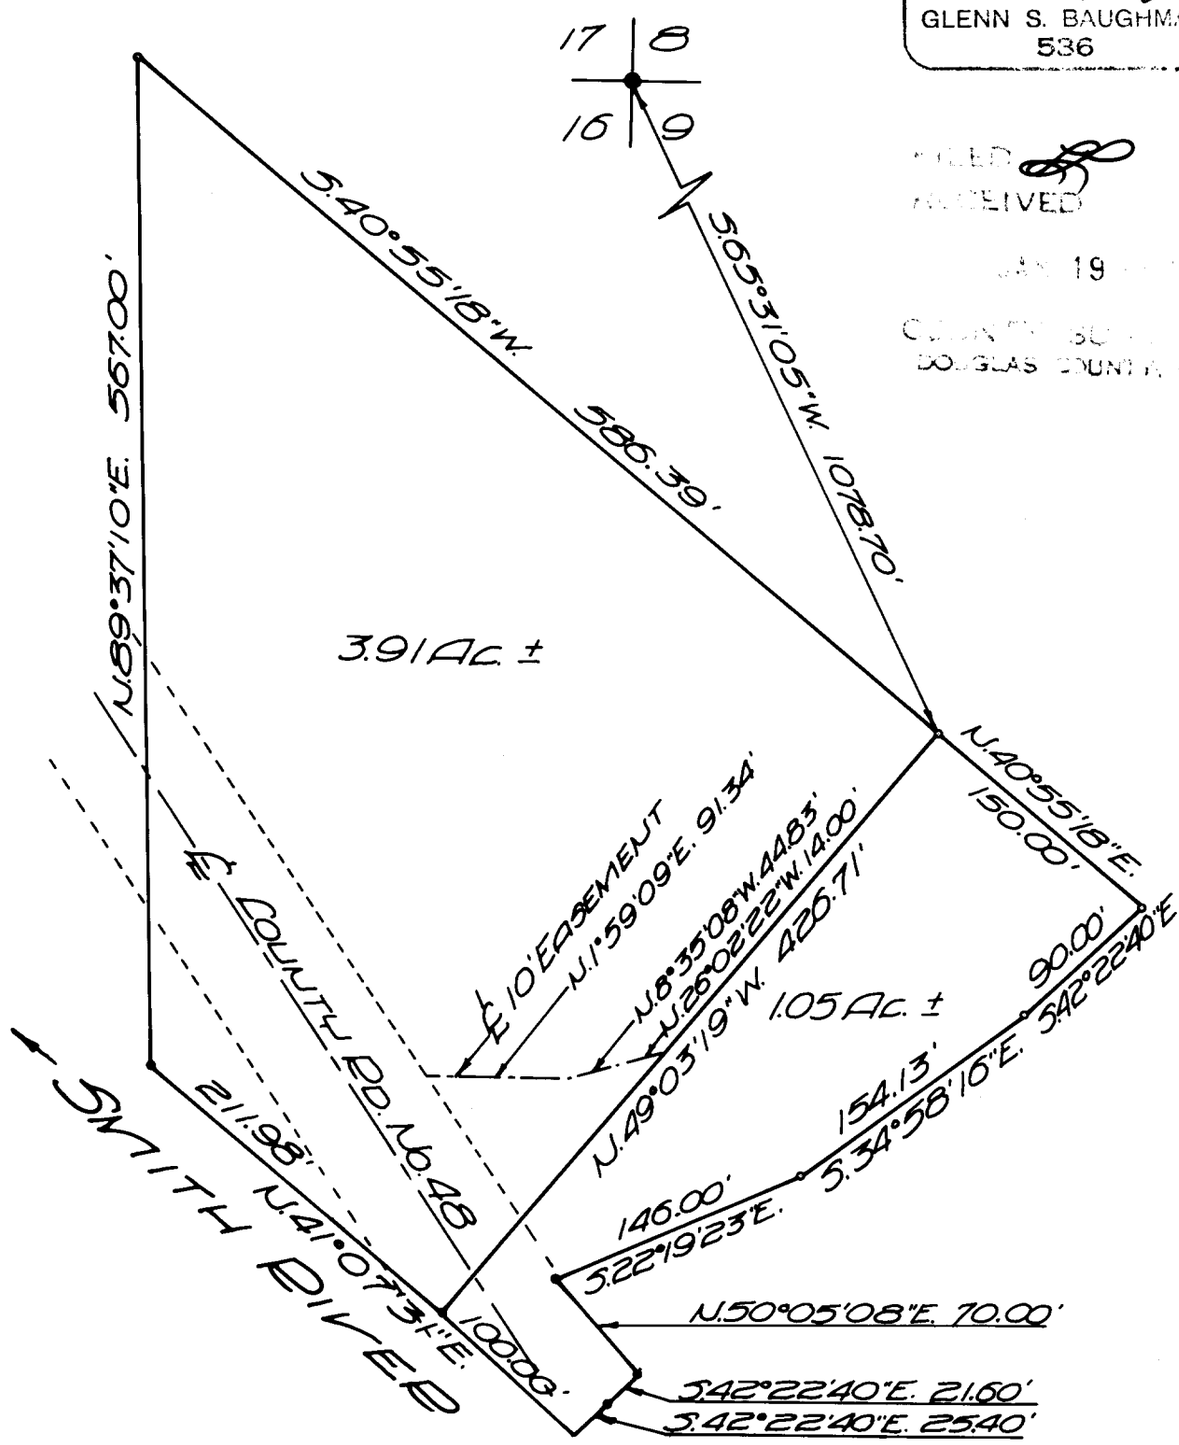

P

55/166-2