T. 25-5 Sec 20

SURVEY IN LOT 4, BLOCK 2, PLAT "O", S.L. & W. CO.

Surveyed For W.T. Beckett by Victor M. McLind

Feb. 1971 **COUNTY SURVEYORS FILE DATA** Scale : 1" = 60'

DO NOT REMOVE FROM OFFICE

o – Indicates Set 5/8" Iron Rod

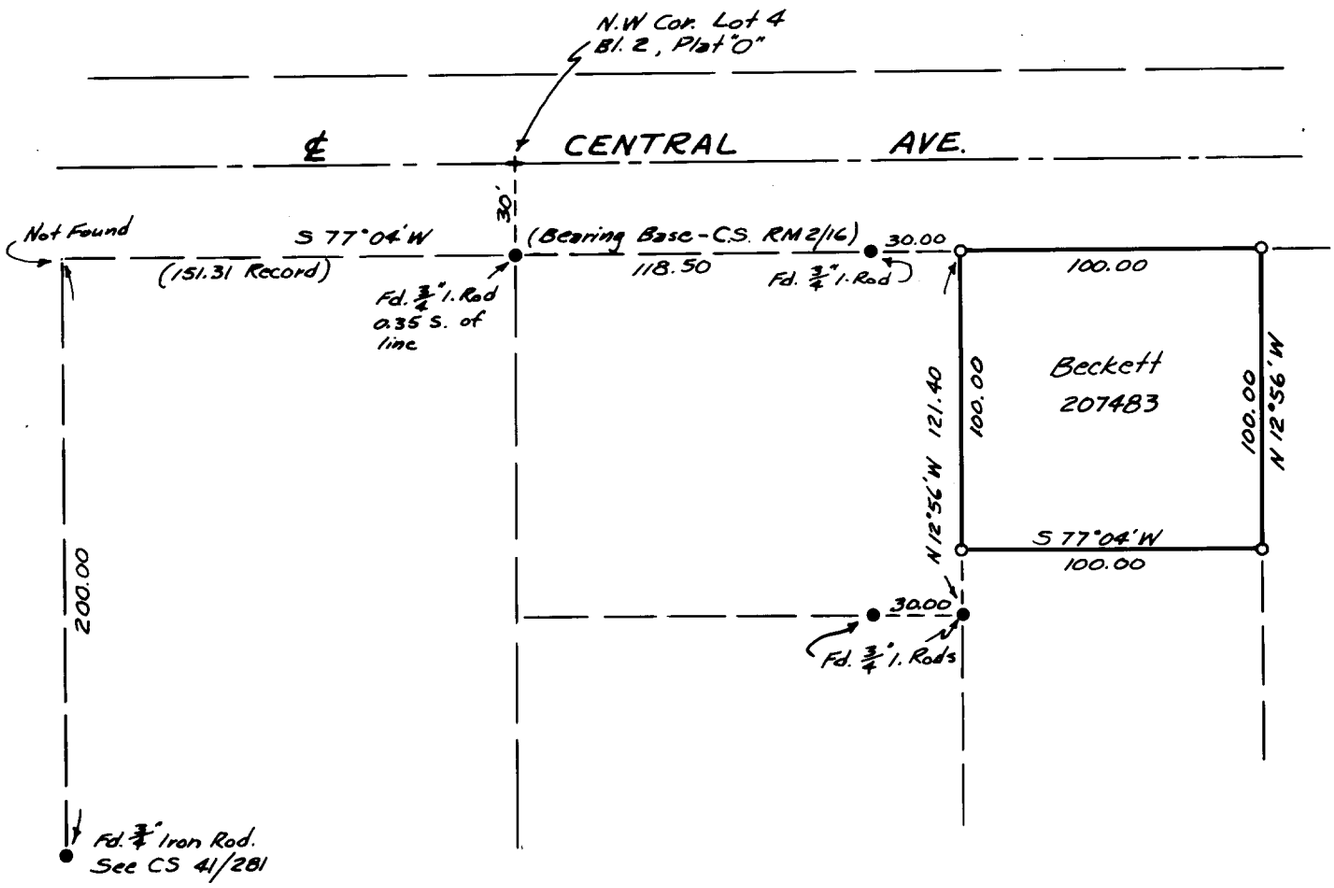

REGISTERED
OREGON
LAND SURVEYOR
Victor M. McLind
VICTOR M. McLIND
1933

FILED
RECEIVED
FEB 11 1971
COUNTY SURVEYOR
DOUGLAS COUNTY, ORE.

P.

55/169-3