COUNTY SURVEYOR FILE DATA
DO NOT REMOVE FROM OFFICE

SURVEYED TO ESTABLISH N 1/16

SITUATED IN N.W. 1/4 SEC. 3, T. 22S, R. 11W.W.M.

SURVEY FOR JIM LARSEN (SPENDTHRIFT RANCH)

BY BAUGHMAN & ACKARET INC.

REGISTERED
OREGON
LAND SURVEYOR

Glenn S. Baughman

JULY 14, 1961
GLENN S. BAUGHMAN
536

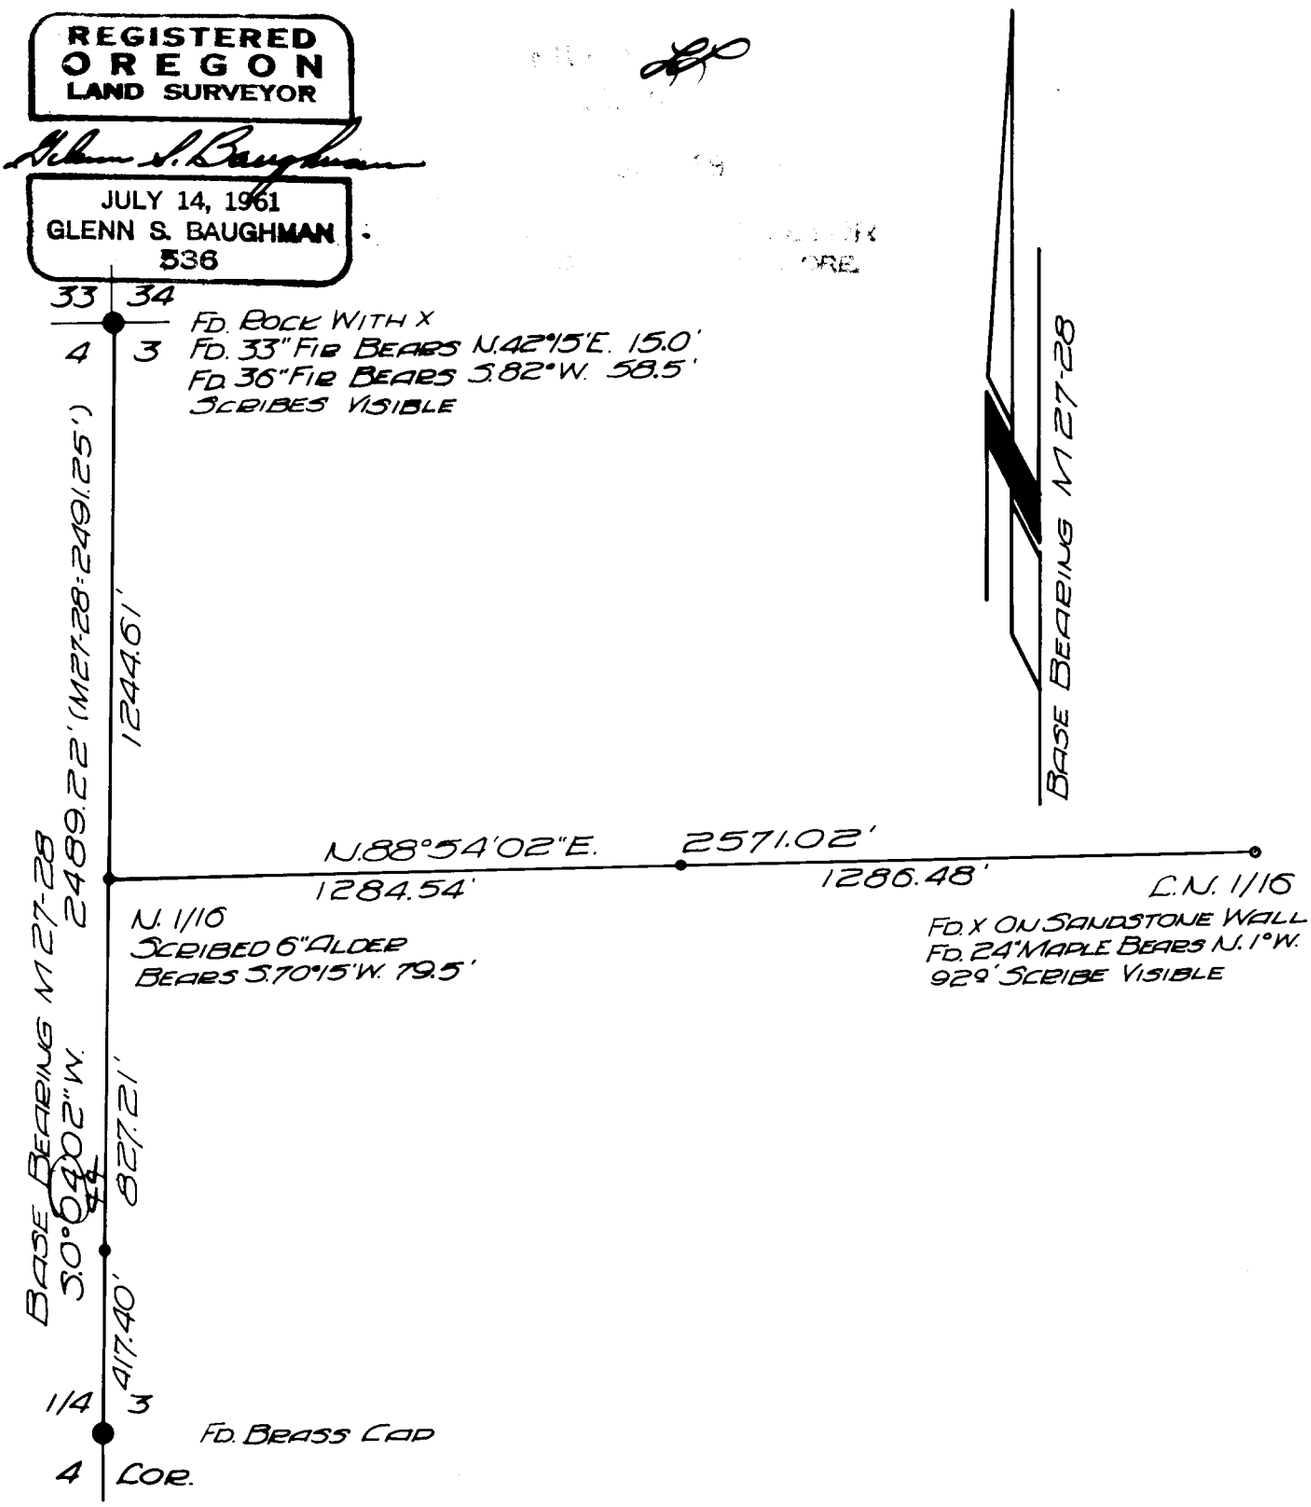

LEGEND:

SCALE: 1" = 400'

- ◉ AS SHOWN
- ○ AS SHOWN
- • SET 5/8" IRON ROD

55/180-1