SURVEY TO ESTABLISH PROPERTY CORNERS
SECTION 16, T.26S., R.6W.W.M.
FOR GEORGE KELLER REALTY
BY BAUGHMAN SURVEYING

SCALE 1" = 400' JANUARY, 1971

LEGEND ● FD. OR SET BRASS CAPS 1968
○ SET 5/8" IRON ROD

COUNTY SURVEYORS FILE DATA
DO NOT REMOVE FROM OFFICE

REGISTERED
OREGON
LAND SURVEYOR

JULY 14, 1961
GLENN S. BAUGHMAN
536

FILED
RECEIVED
JAN 19 1971
COUNTY SURVEYOR
DOUGLAS COUNTY, OREG.

IN THIS SURVEY WE SET CW 1/16 & NW 1/16 FROM POINTS & INFORMATION OBTAINED IN A SURVEY CONDUCTED IN 1968 SEE M35-61

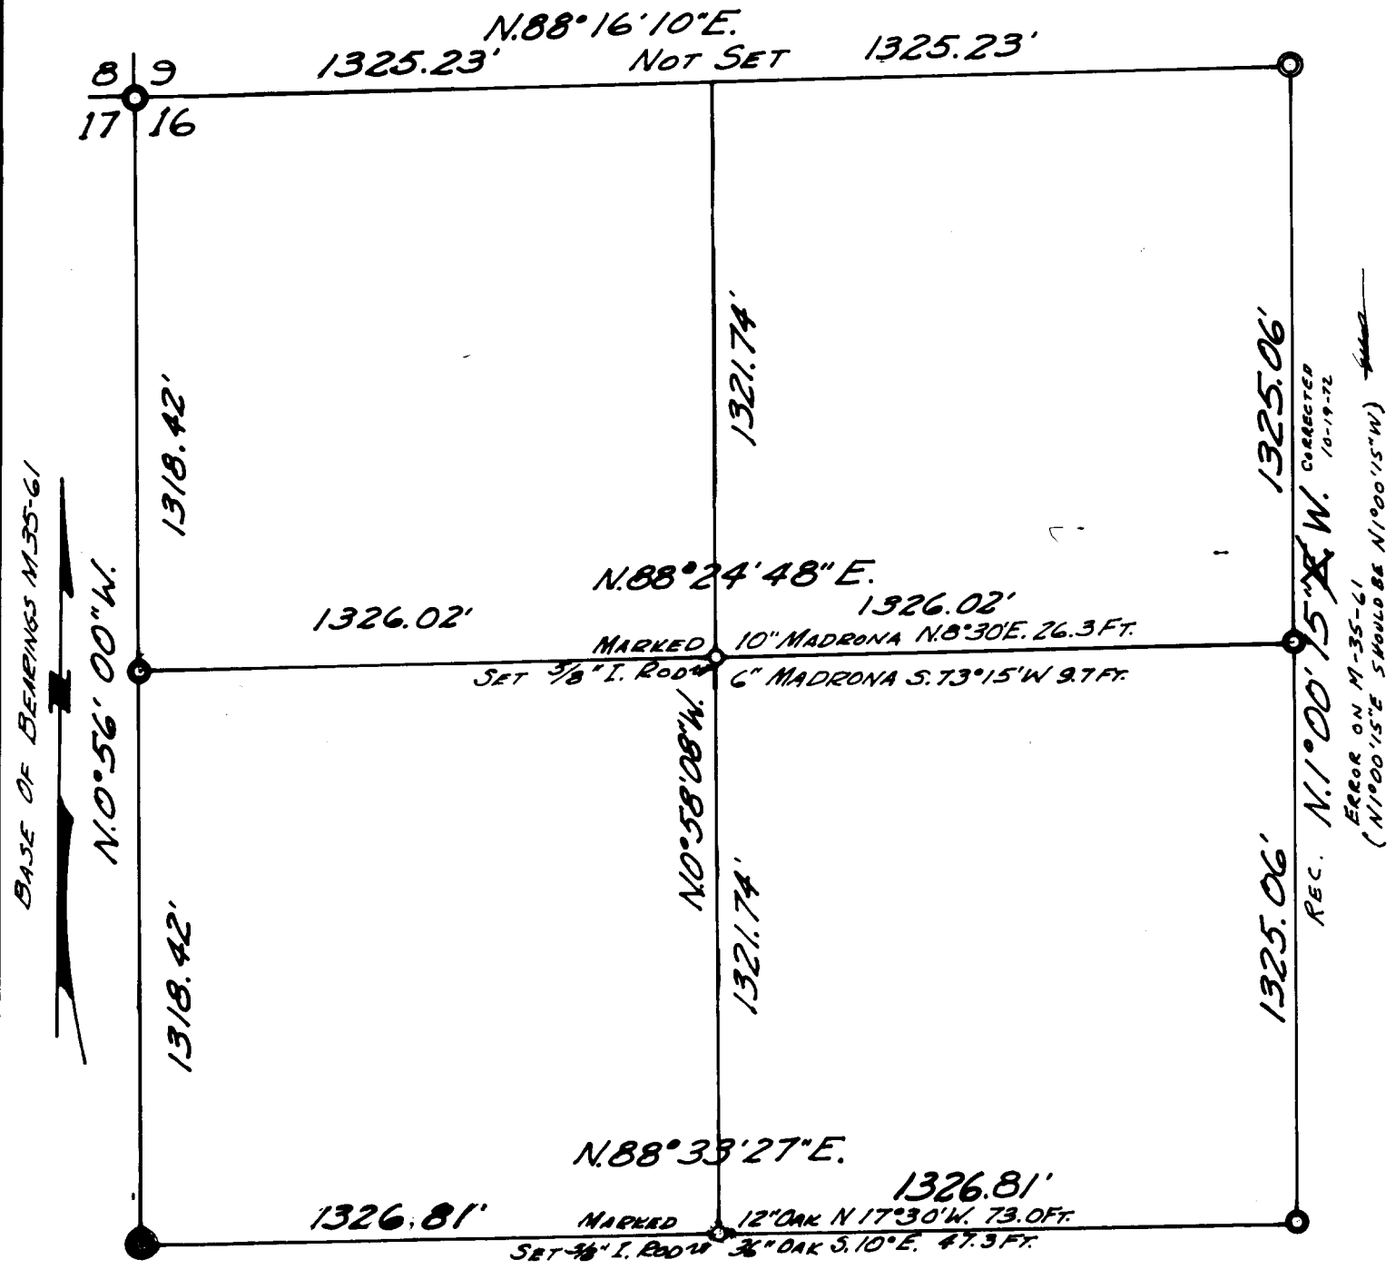

REV. 10-19-72 E.A.B.

55/180