SURVEY FOR DEED DESCRIPTIONS
IN SECTION 30, T.30S., R.5 W.W.M.
FOR ODELL SPAIN
by BRUCE ROGERS
MAY, 1971
1" = 60'

COUNTY SURVEYORS FILE DATA
DO NOT REMOVE FROM OFFICE

REGISTERED
OREGON
LAND SURVEYOR
Bruce R. Rogers
JULY 10 1968
BRUCE R. ROGERS
660
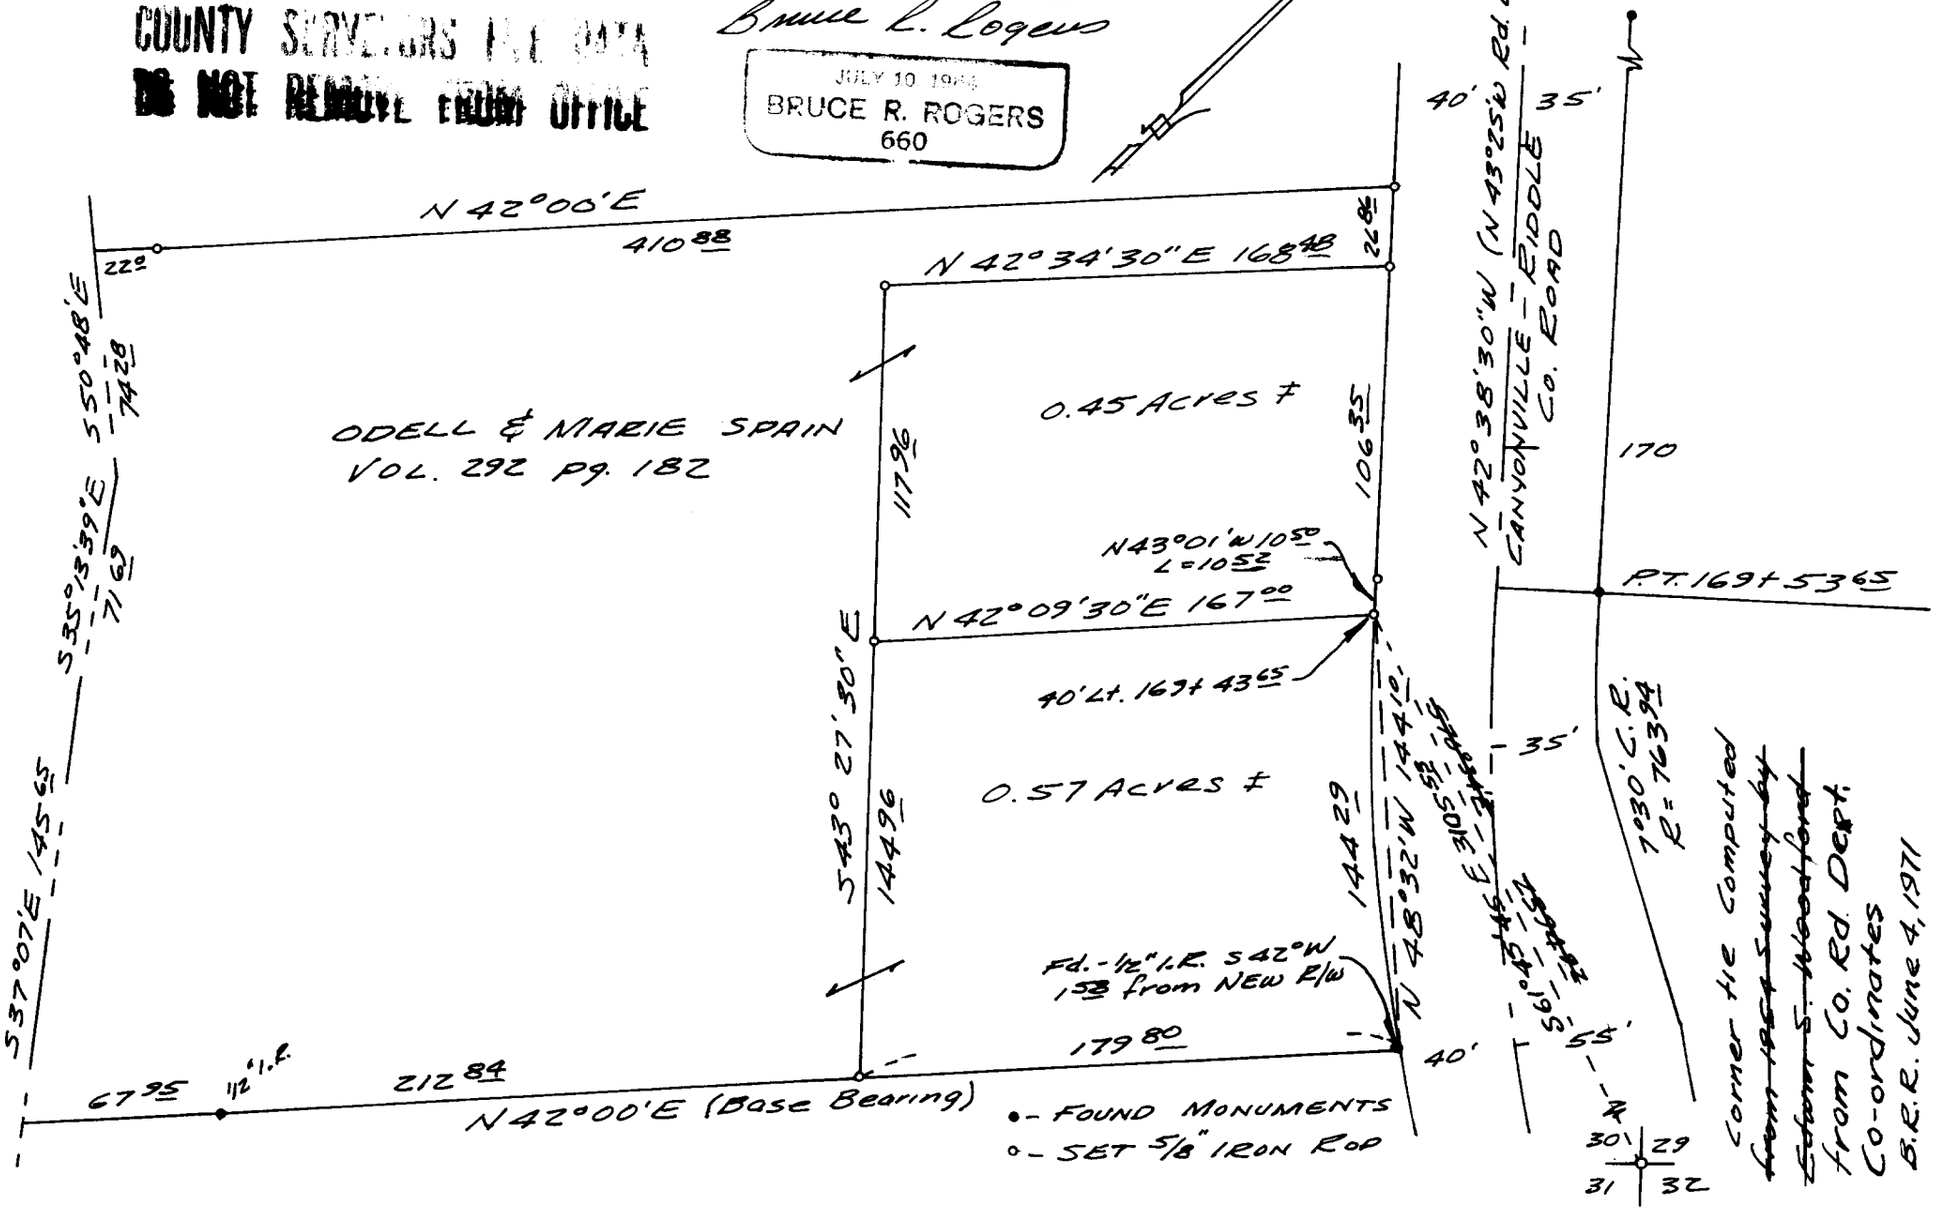
FILED
RECEIVED
JUN 1 1971
COUNTY SURVEYOR
DOUGLAS COUNTY, ORE.
C.S. File No. 55/1971