CERTIFIED RECORD OF LAND CORNER MONUMENTATION

History of original corner establishment:

Never set

DIAGRAM

T20S, R10W, W.M.

S5

S8

E 1/16

Description of corner evidence found:

None

Description of monument and accessories I established to perpetuate the original location of this corner

At the properly proportioned position I placed a 2" x 36" galvanized iron pipe, flanged at the bottom and capped with a bronze disk welded on top. The monument projects 6" above ground. I filled in around the pipe monument with stone and packed earth.

I stamped the disk → E 1/16 S5/S8 1971 4185

I established new bearing trees as follows. Each bearing tree has a scribed face and a U.S.F.S. bearing tree sign breast highand facing the monument.

Bearing trees set:

a 34" maple bears N 20° W 544.2 feet
a 32" alder bears S 24° E 194.7 feet

James W. Byron

Office of County Surveyor County of Douglas
State of Oregon, I hereby certify that the within instrument was filed in this office for record on the 12 day of OCT., 1971, at 10 o'clock A.m., (signed)
James W. Byron by
(COUNTY OFFICIAL) (DEPUTY)

Form R6-7100-57 (9/66)

CORNER #23 ON MAP

C.S File 55 / 201-3

Map File M 43-56

CERTIFIED RECORD OF [redacted] MONUMENTATION

History of original corner establishment:

Never set

DIAGRAM
T 20S, R 10W. W.M.

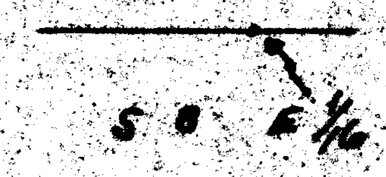

Description of corner evidence found:

None

SEE NEW NOTES DATED 10/12/71

Description of monument and accessories I established to perpetuate the original location of this corner

At a point N 87°48'35" W 20.00 feet from [redacted] the properly proportioned position [redacted] x 36" galvanized iron pipe, flanged at the bottom and capped with [redacted] on top. The monument projects 6" above ground. I filled in around the [redacted]nt with stone and packed earth.

(true corner would fall on stump be[redacted] lower)

stamped this mark →

I established new bearing trees as follows: each bearing tree has a scribed face and a U.S.F.S. bearing tree sign [redacted] and facing the monument.

Bearing trees set:

a 34" maple bears N 25° W 5[redacted]
a 32" alder bears S 10° E 19[redacted]

Office of County Surveyor, County of Douglas
State of Oregon, I hereby certify that the [redacted] instrument was filed in this office for record on the [redacted] of June, [redacted] 19 71, at [redacted] o'clock [redacted] (signed)
[redacted] by
(DEPUTY)

C.S File 55 [redacted]

Map File [redacted]

Form R6-7100-57 (9/66)