SURVEY FOR DEED DESCRIPTION

SITUATED IN SEC. 11, T. 29S., R. 6, W.W.M.

SURVEY FOR AUER JERSEY DAIRY

BY BAUGHMAN SURVEYING SERVICE

Scale 1" = 50'

June 1971

FILED
RECEIVED
JUL 1 1971
COUNTY SURVEYOR
DOUGLAS COUNTY, ORE.

COUNTY SURVEYORS FILE DATA
DO NOT REMOVE FROM OFFICE

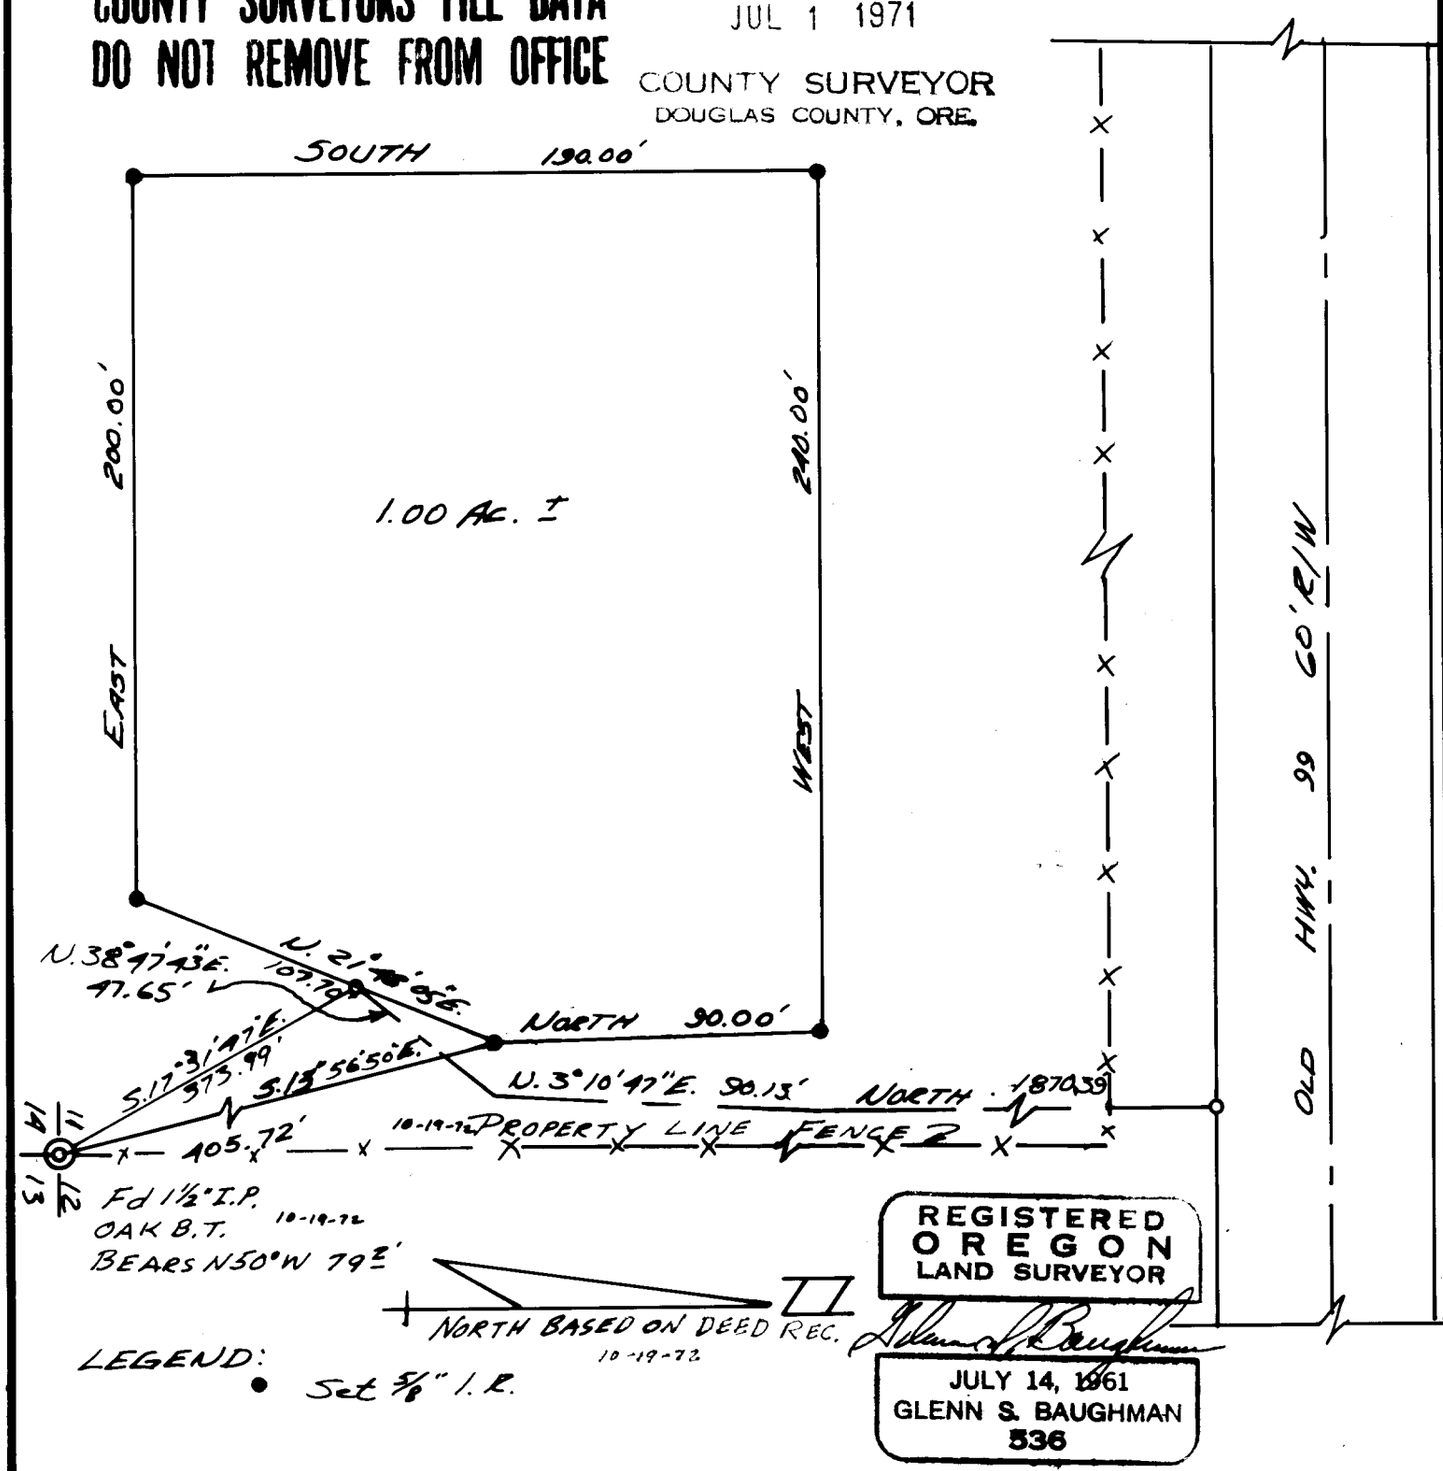

REV. 10-19-72 E.A.B.

55/203-1