REFERENCE
AT ¼ Cor Sects. 17 + 18 T. 22 S. R. 5 W. W.M.

Scale 1" = 20'

Sept. 24, 1971

FILED
RECEIVED

OCT 7 1971

COUNTY SURVEYOR
DOUGLAS COUNTY, ORE.

REGISTERED
OREGON
LAND SURVEYOR
Wilford N. Haines
MAY 7, 1948
WILFORD N. HAINES
239

COUNTY SURVEYORS FILE DATA
DO NOT REMOVE FROM OFFICE

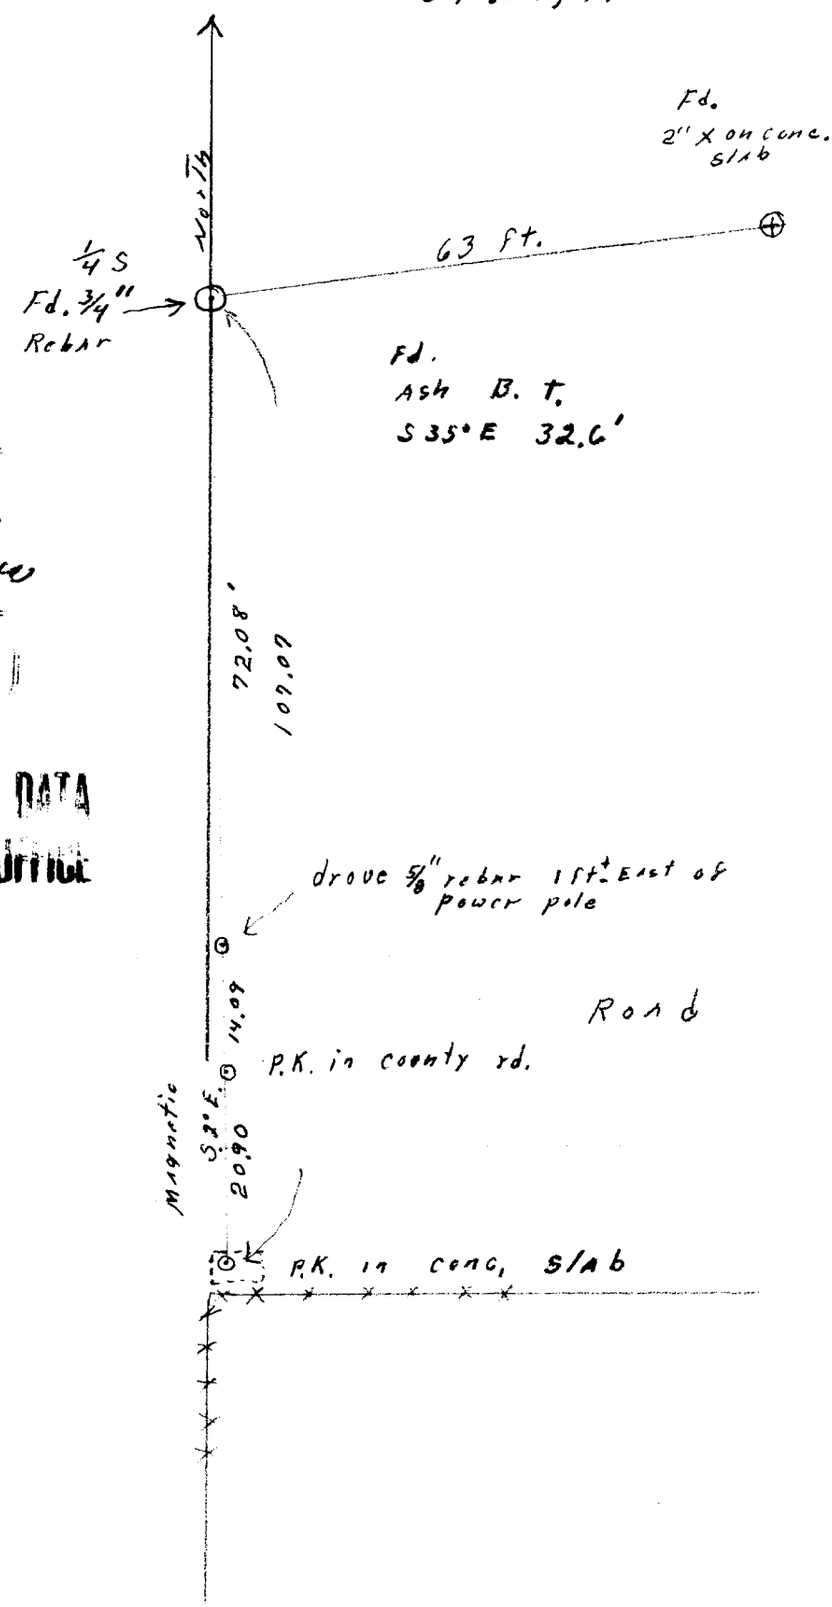

Paved

Road

SEE REN. #124

FOR DRAIN PLYWOOD

S. File No. 55/216