A SURVEY TO ESTABLISH PROPERTY CORNERS

IN SECTION 5 TWP. 23 SOUTH RANGE 4 WEST W.M.

SURVEYED FOR DOUGLAS COUNTY ROAD DEPT.

SURVEYED OCT. 21, 1971

SCALE 1"=100'

COUNTY SURVEYORS FILE DATA
DO NOT REMOVE FROM OFFICE

BASE OF BEARINGS TAKEN FROM THE CENTER LINE OF YONCALLA ELKHEAD COUNTY ROAD NO.7

● FD. 5/8" IRON ROD

o SET 5/8" IRON ROD

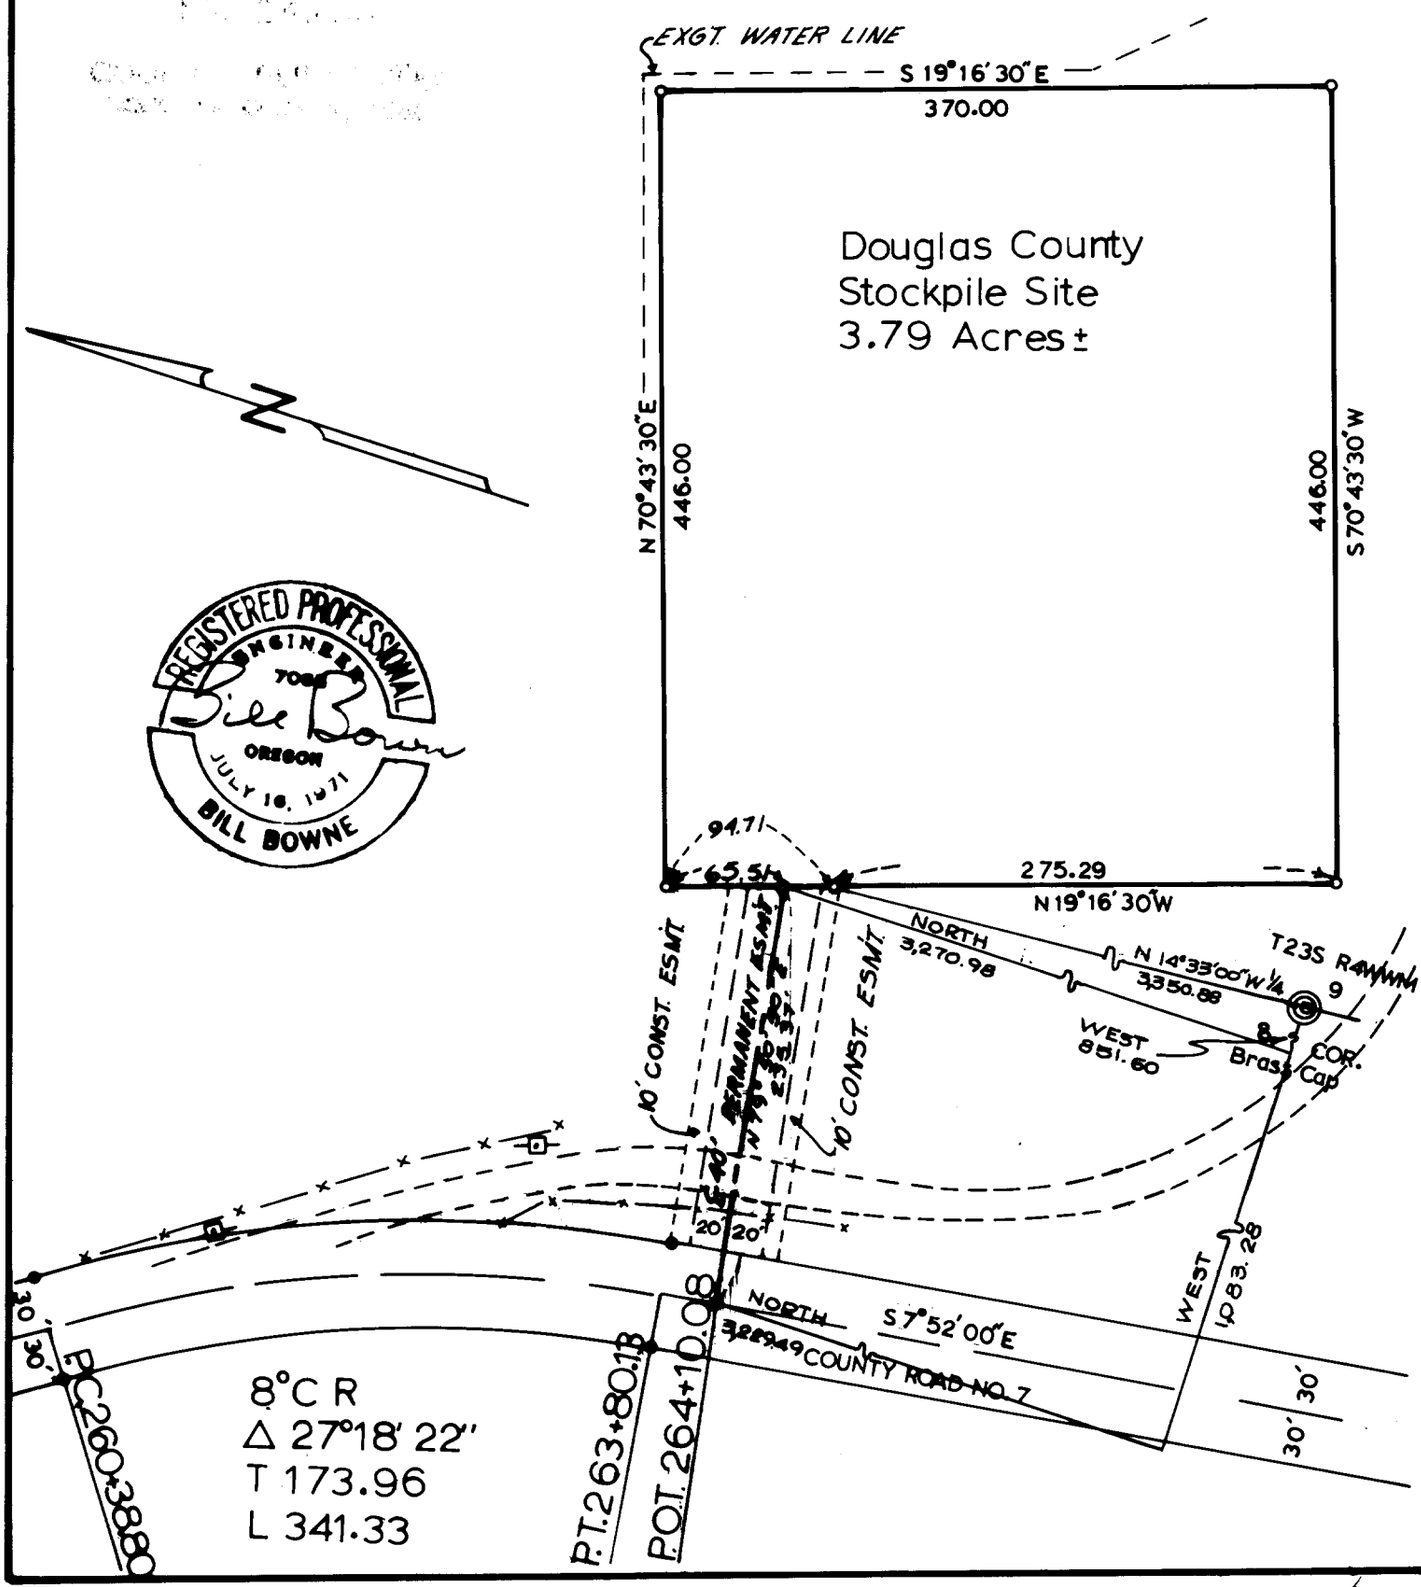

REGISTERED PROFESSIONAL ENGINEER 7088 OREGON JULY 16, 1971 BILL BOWNE