COUNTY SURVEYORS FILE DATA
DO NOT REMOVE FROM OFFICE

T. 26 - 3 - Sec 11

SURVEY TO SET PROP. CORS. IN LOTS 9 & 10, NORTH UMPQUA HOMES
SURVEYED DEC. 1971 BY
BAUGHMAN SURVEYING SERVICE FOR
HARVEY PEEKE SCALE: 1" = 100'

FILED
RECEIVED
JAN 4 1972
COUNTY SURVEYOR
DOUGLAS COUNTY, ORE.

● = 1/2" I. PIPE, F.D.
⌑ = AS SHOWN.
○ = 5/8" I. ROD SET.

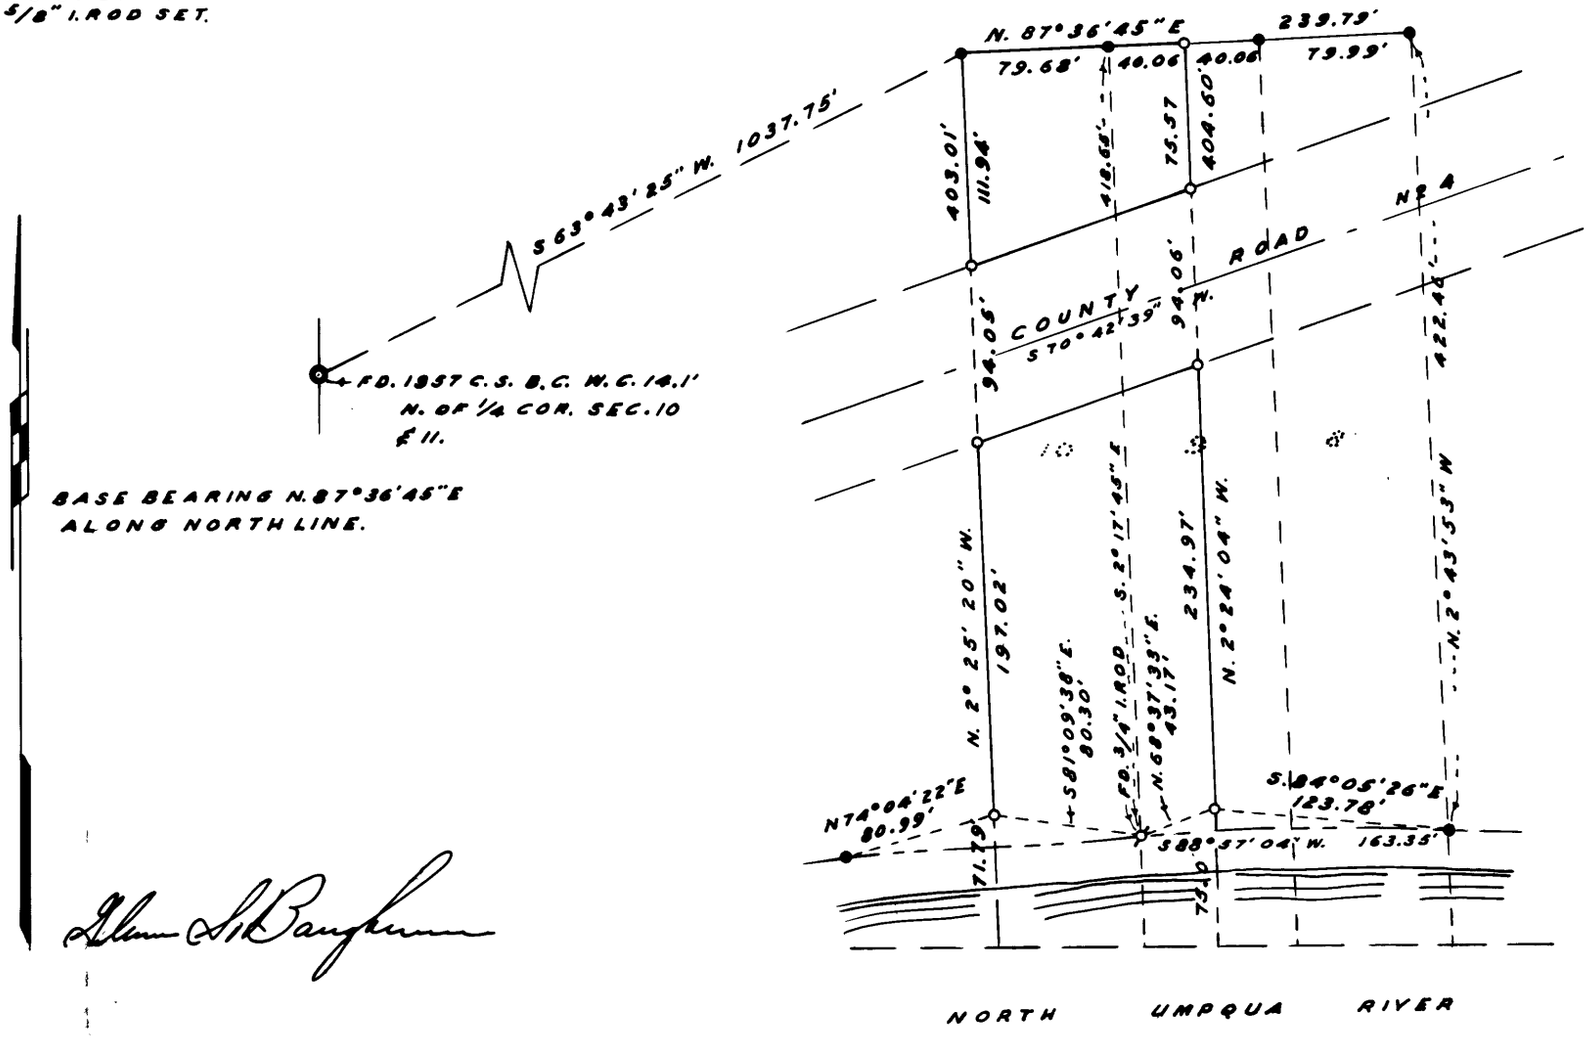

Glenn S. Baughman

P

C. S. File No. 55/225-2