COUNTY SURVEYORS FILE DATA
DO NOT REMOVE FROM OFFICE

T. 27-6 Sec. 25

SURVEY IN BLOCK 30, AMENDED PLAT OF THE TOWNSITE OF SUTHERLIN

Surveyed for Jim Abbott by Victor M. McLind

February 1972 Scale: 1" = 40'

○ ~ Set 5/8" I. Rod

● ~ Fd. 5/8" I. Rod, unless otherwise noted

FILED
RECEIVED G.L.
FEB 24 1972
COUNTY SURVEYOR
DOUGLAS COUNTY, ORE.

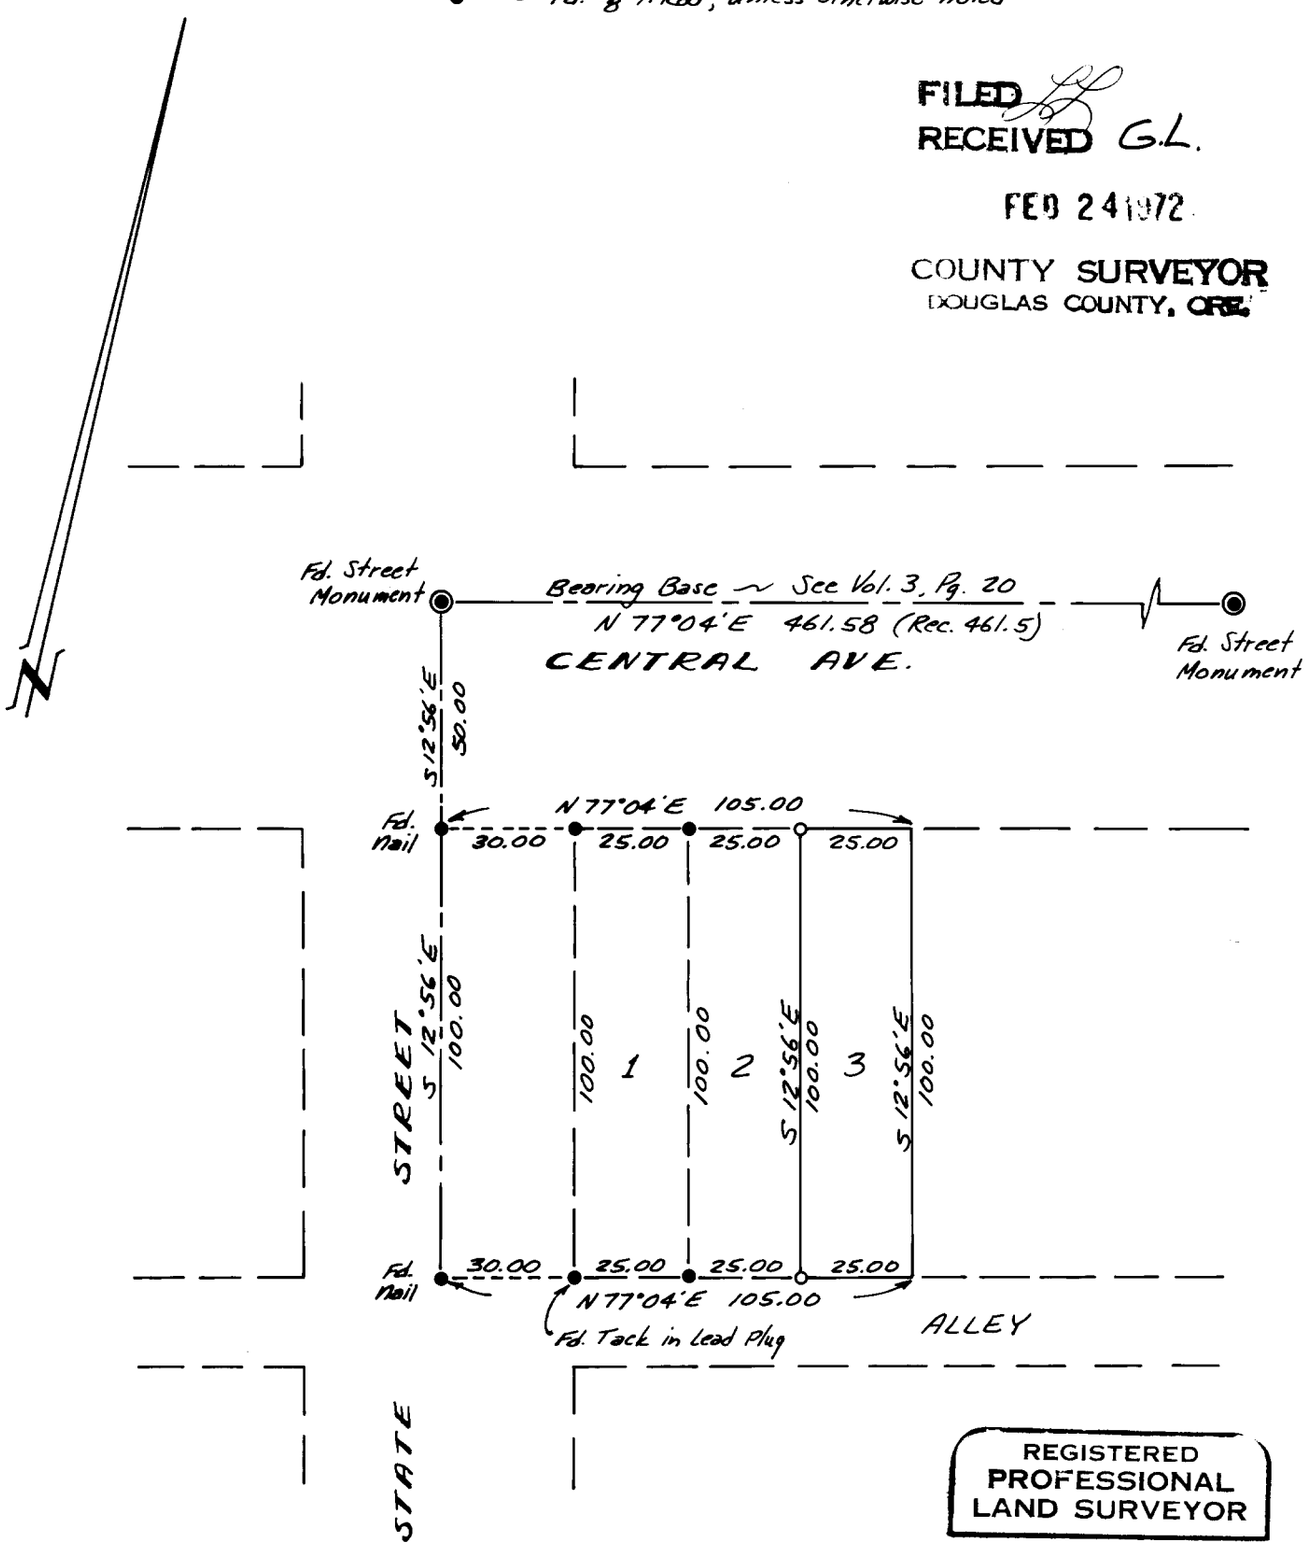

REGISTERED
PROFESSIONAL
LAND SURVEYOR
Victor M. McLind
OREGON
JULY 17, 1970
VICTOR M. McLIND
934

C. S. File No. 55/231-3

REFER TO M43-60