T 27-6 Sec 24

SURVEY TO SET PROPERTY CORNERS
LOTS 5 & 6, BLOCK 1, SUNNY ACRES
ROSEBURG, OREGON
FOR THE FLYING "J" OIL CO.
by BRUCE ROGERS
FEB., 1972
1" = 60'

COUNTY SURVEYORS FILE DATA
DO NOT REMOVE FROM OFFICE

REGISTERED
OREGON
LAND SURVEYOR

Bruce R. Rogers

JULY 10, 1954
BRUCE R. ROGERS
660

FILED
RECEIVED
MAR 1 1972
COUNTY SURVEYOR
DOUGLAS COUNTY, ORE.

• FOUND MONUMENTS
∘ SET 5/8" Iron Rod

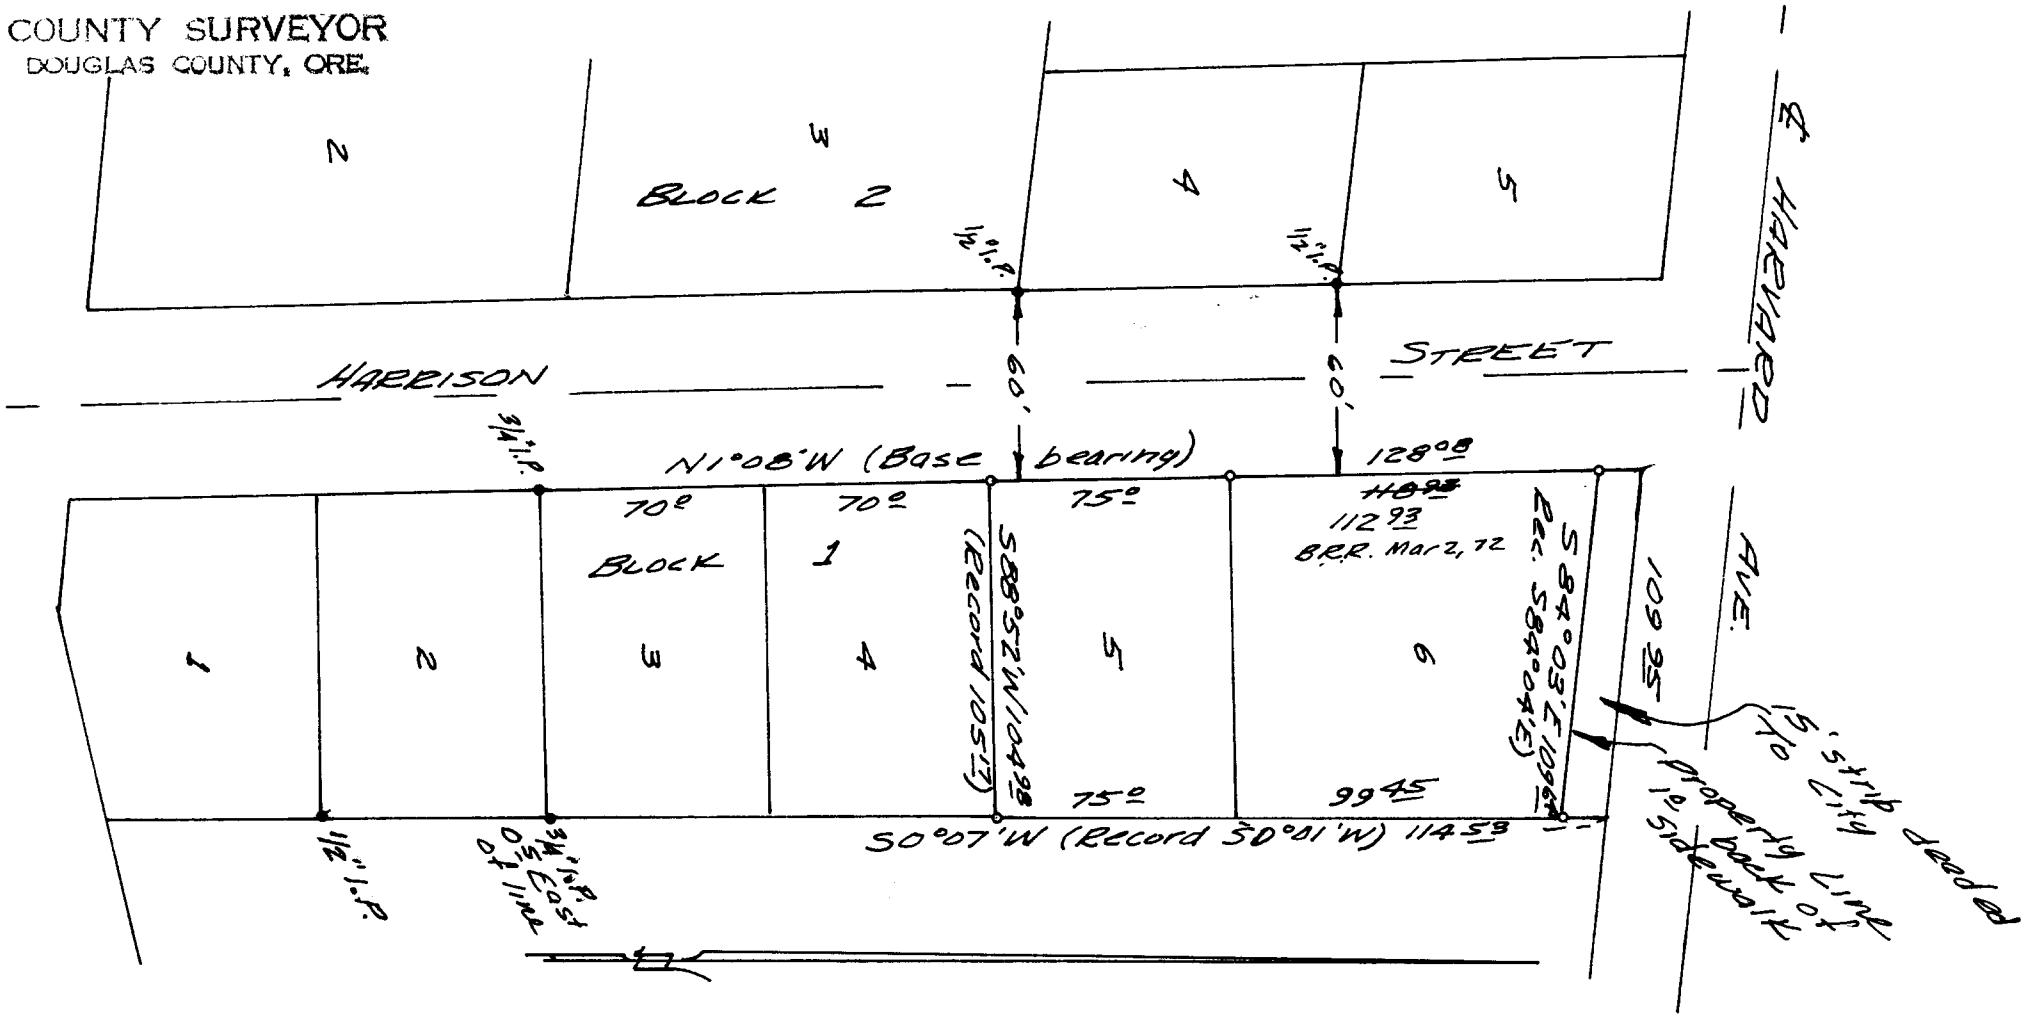

P C. S. File No. 55/237-2