SURVEY IN BLOCK 34, AMENDED PLAT OF THE TOWNSITE OF SUTHERLIN

Surveyed for Lois E. Bryant by Victor M. McLind

February 1972 Scale: 1" = 50'

COUNTY SURVEYORS FILE DATA
DO NOT REMOVE FROM OFFICE

○ ~ Set 5/8" Iron Rod
● ~ Fd. 3/4" Iron Pipe

FILED
RECEIVED G.L.
FEB 24 1972
COUNTY SURVEYOR
DOUGLAS COUNTY, ORE.

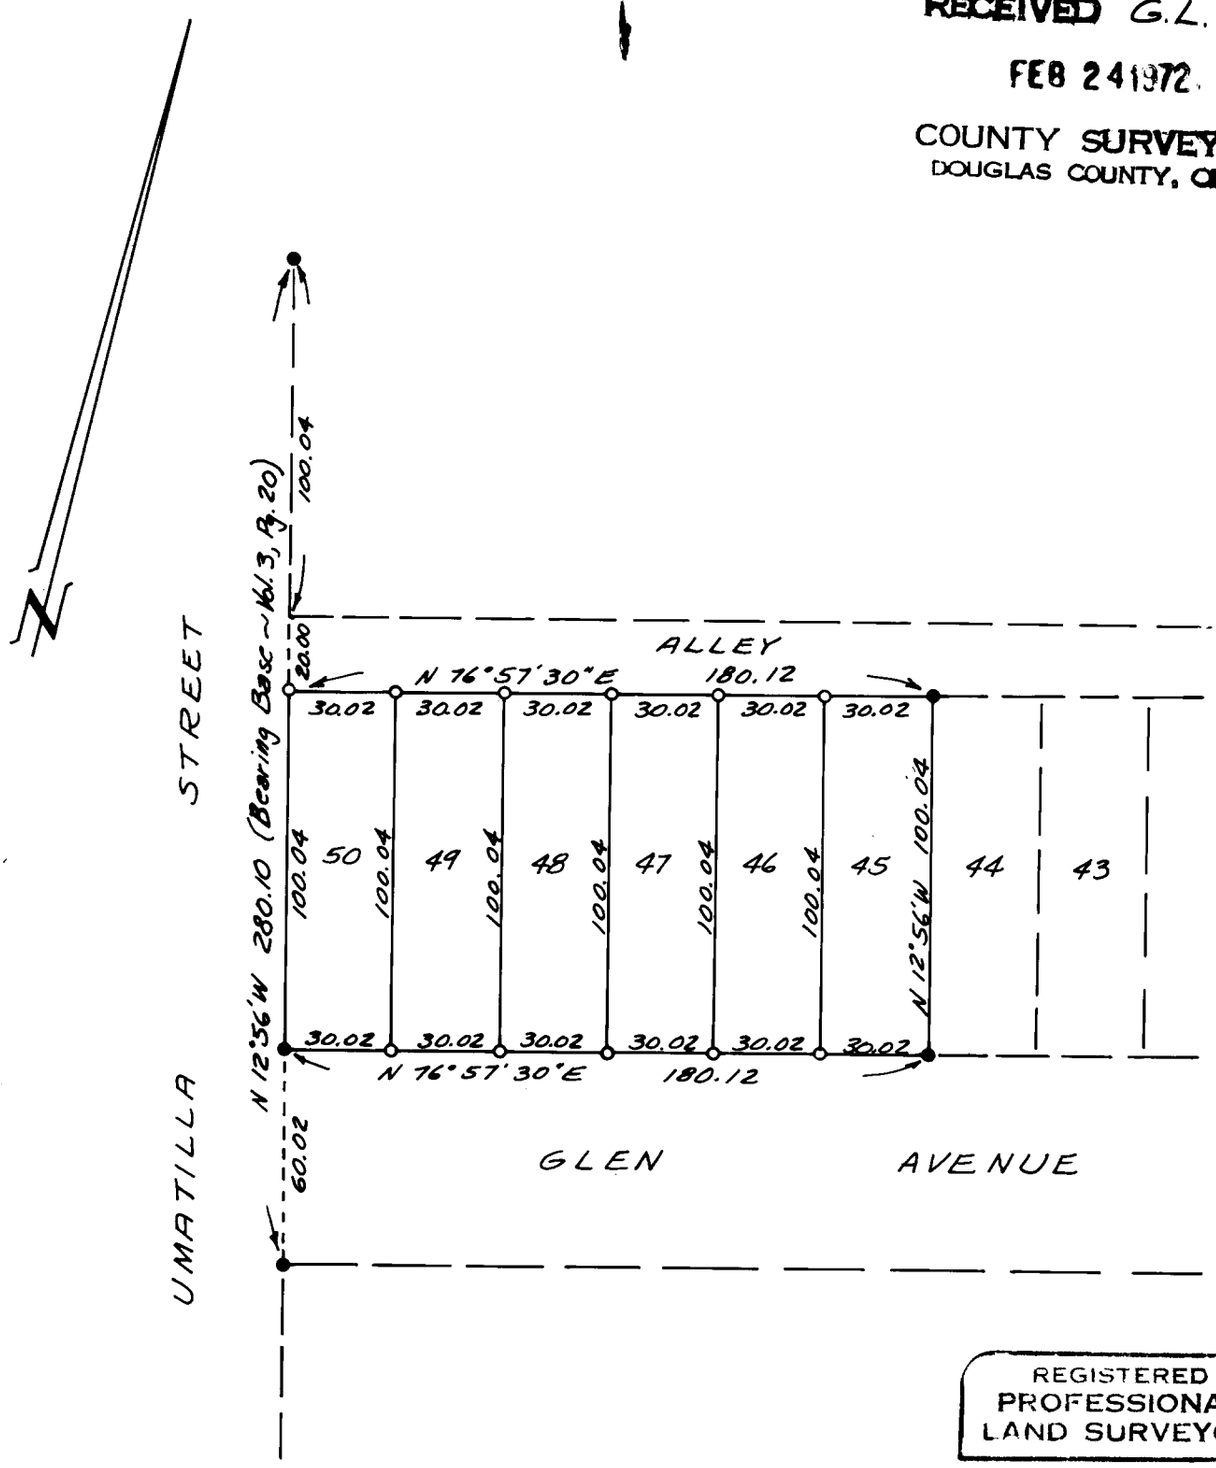

REGISTERED
PROFESSIONAL
LAND SURVEYOR

Victor M. McLind

OREGON
JULY 17, 1970
VICTOR M. McLIND
934

P C. S. File No. 55/240

REFER TO M 41-11