SURVEY FOR PROPERTY CORNERS
A PORTION OF LOT 5 PHILIPPI ACRES
IN SEC. 21, T.26S., R.4 W.W.M.
SURVEY FOR MRS LILYAN KING
BY BAUGHMAN SURVEYING SERVICE
SCALE 1" = 40' APRIL 1972

FILED
RECEIVED
[illegible] 8 1972
COUNTY SURVEYOR
DOUGLAS COUNTY, ORE.

Revised 6-7-72

LEGEND
Fd. ¾" I.P.
Fd. 2" I.P.
Set ¾" I.P.

COUNTY SURVEYORS FILE DATA
DO NOT REMOVE FROM OFFICE

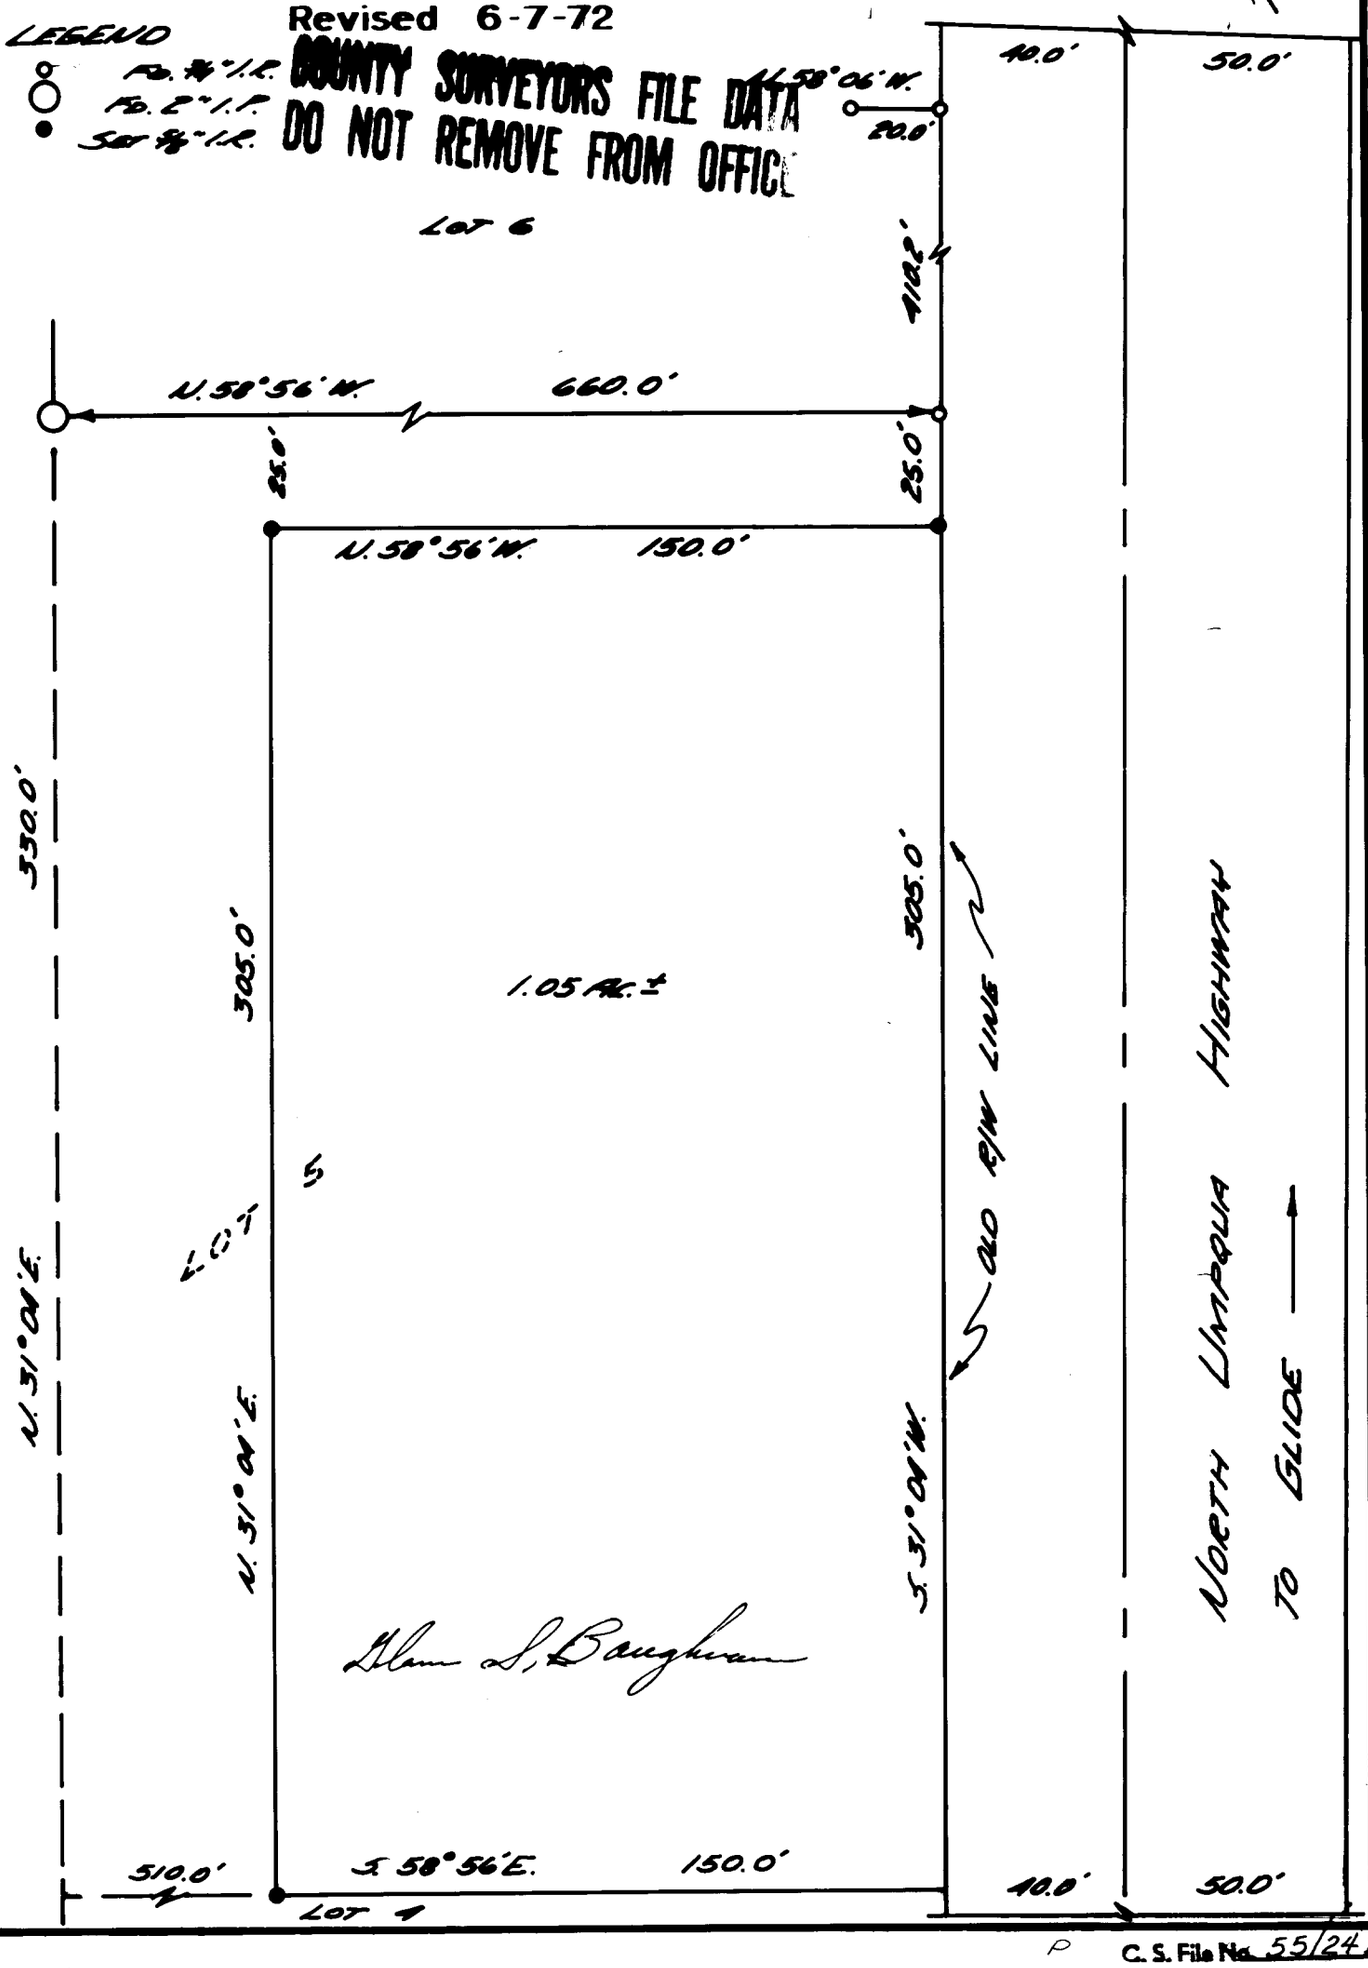

C. S. File No. 55/241