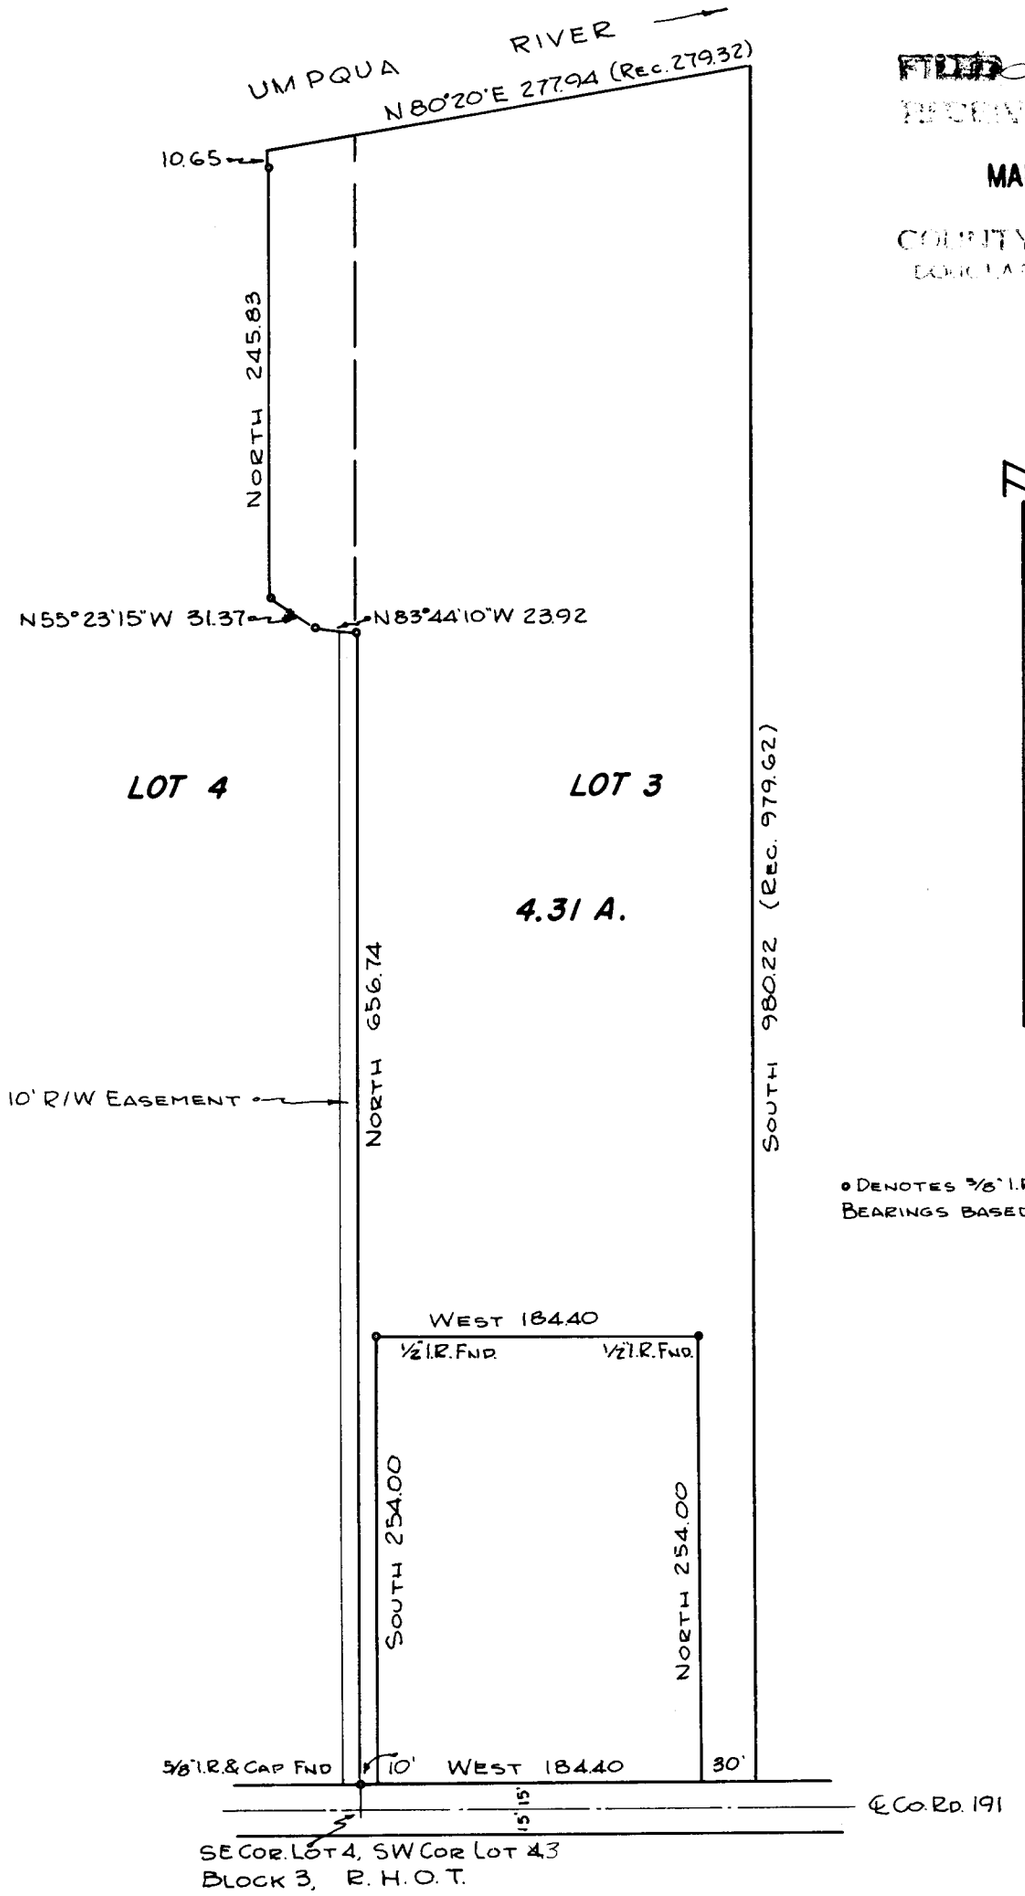

FILED

RECEIVED

MAR 7

COUNTY SURVEYOR
DOUGLAS COUNTY, ORE.

N

o DENOTES 5/8" I.R. SET
BEARINGS BASED ON C.S. MAP FILE 28-42

SURVEY IN LOTS 3 AND 4, BLOCK 3,
ROSEBURG HOME ORCHARD TRACTS
SURVEYED FOR SAMUEL E. LONG
SURVEYED BY R. H. GEE - MARCH, 1972
SCALE 1" = 100'

T.26 R.6 W.W.M.

COUNTY SURVEYORS FILE DATA
DO NOT REMOVE FROM OFFICE

REGISTERED PROFESSIONAL ENGINEER
3723
OREGON
OCT. 22, 1954
R. H. GEE

C. S. File No. 55/244 - 3